

FORREST MISSISSIPPI BOARD OF WATER COMMISSIONERS

D 2000
7-3-62

WATER WELL DRILLERS LOG

Date: 7-3, 1962, Driller: W. H. Moore County: Forrest

(Name)

(1) Owner of Land:	Description & Color of Materials Sand, Clay, Red Clay, Shell, etc.	Thick- ness Feet	Depth Feet
<u>W. E. Ward.</u> (Name)	<u>Red sand & clay</u>	<u>6</u>	
<u>Nattabury Miss</u> (Address)	<u>Sand & clay, white.</u> <u>on bottom</u>	<u>26</u>	
(2) Location: $\frac{1}{4}$, $\frac{1}{4}$, Sec. <u>20</u> T. <u>R</u>			
_____ miles _____ of _____ (distance) (direction) (Nearest Town)			
(3) Topography: _____ (Hilly) (Flat) (Level)			
(4) Purpose of Well: <u>Drinking water</u> (Domestic Irrigation Municipal, Industrial, Other)			


Information upon completion of wells:

- (1) Diameter 2" inches.
- (2) Total Depth 32 feet.
- (3) Water level 21 feet below top of ground.
- (4) Cased to 32', Size 2"
- (5) Screen: Size 1', Length 5'
- (6) Were any formations sealed against pollution?
_____ yes, _____ no.

If YES depth of formation _____

Why _____

Drillers Remarks: _____

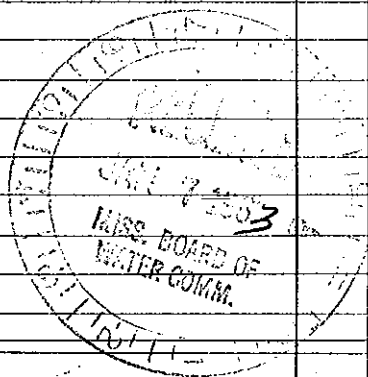

(Use Back Side)

Well No. _____

Mail this copy to Board of Water Commissioners 429 Miss. St. Jackson, Miss.