

FORREST

MISSISSIPPI BOARD OF WATER COMMISSIONERS

D 2005  
5-19-64

WATER WELL DRILLERS LOG

Date: 5-19, 1964, Driller: W. H. Moody, County: Forrest

(Name)

(1) Owner of Land:	Description & Color of Materials Sand, Clay, Red Clay, Shell, etc.	Thick- ness Feet	Depth Feet
(Name) Reed McCaffrey	Super 0	10	10
(Address) Wattsburg Miss	Sarl 4' 10'	35	25
(2) Location: _____ 1/4, _____ 1/4, Sec. _____ T. _____ R. _____	Blue 3'	121	86
_____ miles _____ of _____ (distance) (direction) (Nearest Town)	Sarl 4' 10'	130	9
(3) Topography: _____ (Hilly) (Flat) (Level)			
(4) Purpose of Well: _____ (Domestic Irrigation, Municipal, Industrial, Other)			

Information upon completion of well:


- (1) Diameter: 4' inches. Plastic
- (2) Total Depth: 130 feet.
- (3) Water Level: 21 feet below top of ground.
- (4) Cased to: 121, Size 4'
- (5) Screen: Size 4", Length 5'
- (6) Were any formations sealed against pollution?  
\_\_\_\_\_ yes, \_\_\_\_\_ no.

If YES depth of formation \_\_\_\_\_

Why \_\_\_\_\_

Drillers Remarks: all Plastic

2 1/2" 10' 100  
7' 1/2" 10' 100  
Pump 1 Gal. 10' 4' 100

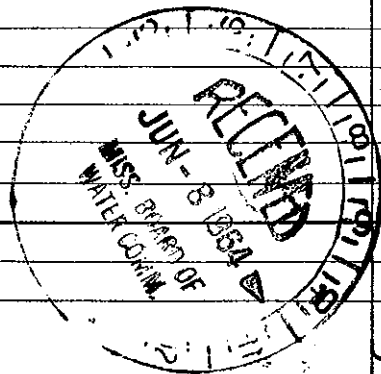

(Use Back Side)

Well No. 34

Mail this copy to Board of Water Commissioners 429 Miss. St. Jackson, Miss.