

Forrest
E 12
9-66

MISSISSIPPI BOARD OF WATER COMMISSIONERS

③ WATER WELL DRILLERS LOG

Date: 9-1, 1966, Driller: H.P. Drilling Co. County: Forrest
1046 Thompson Blvd. (Address)

(1) Owner of Land (Name) (Address)	Description & Color of Materials Sand, Clay, Red Clay, Shell, etc.	Thick- ness Feet	Depth Feet
Lillymae Myers	Red clay	10	10
P.O. Hattiesburg Miss	" " sand	10	20
(2) Location: NE 1/4, NW 1/4, Sec 28 T4N R12E	white chalk	15	35
9 miles East of Hattiesburg	gray "	10	45
(3) Topography: Hilly	clay "	15	60
(4) Purpose of Well: Home	fine sand	5	65
	hard sand the sand	20	85


Information upon completion of well:

- (1) Diameter 2 inches.
- (2) Total Depth 85 feet.
- (3) Water Level 50 feet below top of ground.
- (4) Cased to 80, Size 2 in
- (5) Screen: Size 2 in, Length 5 ft
- (6) Were any formations sealed against pollution?
yes, no.

If YES depth of formation _____

Why _____

Drillers Remarks: _____

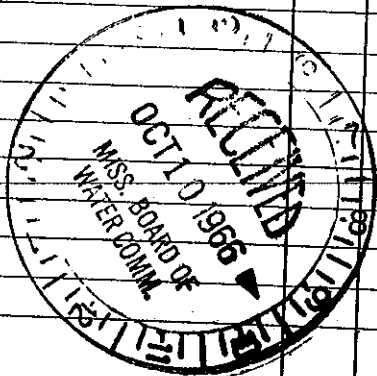

Well No. _____

(Use Back Side)

Mail this copy to Board of Water Commissioners 429 Miss. St. Jackson, Miss.