

Forest
E 13
8-66 ③

MISSISSIPPI BOARD OF WATER COMMISSIONERS

WATER WELL DRILLERS LOG

Date: Aug 10, 1966, Driller: S. & R. Drilling County Forest
(Name)

(1) Owner of Land:	Description & Color of Materials Sand, Clay, Red Clay, Shell, etc.	Thick- ness Feet	Depth Feet
<u>Hardie McCloud</u> (Name)	<u>Red Clay</u>	<u>0</u>	<u>10</u>
<u>Hattiesburg Miss Route</u> (Address)	<u>white + red clay</u>	<u>10</u>	<u>20</u>
(2) Location: <u>SE 1/4, SW 1/4, Sec. 11</u> <u>4 12</u> T N R L W	<u>sand + gravel</u>	<u>20</u>	<u>35</u>
<u>8 1/2</u> miles <u>East</u> of <u>Hattiesburg</u> (distance) (direction) (Nearest Town)	<u>white shell</u>	<u>35</u>	<u>50</u>
(3) Topography: <u>Flat</u> (Hilly) (Flat) (Level)	<u>Blue chert</u>	<u>50</u>	<u>90</u>
(4) Purpose of Well: <u>Farm</u> (Domestic Irrigation Municipal, Industrial, Other)	<u>Blue clay + shell</u>	<u>90</u>	<u>140</u>
	<u>clay + sand</u>	<u>140</u>	<u>218</u>
	<u>trap sand</u>	<u>218</u>	<u>235</u>


Information upon completion of well:

- (1) Diameter 4 inches.
- (2) Total Depth 235 feet.
- (3) Water Level 110 feet below top of ground.
- (4) Cased to 225, Size 4 in.
- (5) Screen: Size 4, Length 10 ft.
- (6) Were any formations sealed against pollution?
 yes, no.

If YES depth of formation _____

Why _____

Drillers Remarks: _____

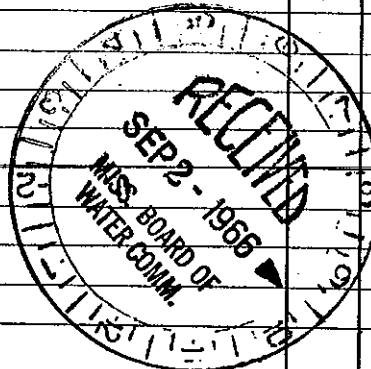

Well No. _____

(Use Back Side)

Mail this copy to Board of Water Commissioners 429 Miss. St. Jackson, Miss