

FORREST MISSISSIPPI BOARD OF WATER COMMISSIONERS

E 14 (3)
3-9-66

WATER WELL DRILLERS LOG

Date: 3-9, 1966, Driller: Gene *St R Drilling* County FORREST
(Name)

(1) Owner of Land FORREST BARNES
(Name)
RT 7 HATTIESBURG, MISS
(Address)

(2) Location: NE 1/4, NW 1/4, Sec. 17 T4R12 ^{N W}
2 miles S. E of HATTIESBURG
(distance) (direction) (Nearest Town)

(3) Topography: Hilly
(Hilly) (Flat) (Level)

(4) Purpose of Well: HOME
(Domestic Irrigation, Municipal, Industrial, Other)


Description & Color of Materials Sand, Clay, Red Clay, Shell, etc.	Thick- ness Feet	Depth Feet
SANDY CLAY	6	6
WHITE SAND	15	21
Red SAND + CLAY STRIPS	33	54
SAND ROCK	1	55
WHITE CLAY	28	83
WHITE SAND + GRAVEL	62	145

Information upon completion of well:

- (1) Diameter 2 inches.
- (2) Total Depth 145 feet.
- (3) Water Level 58 feet below top of ground.
- (4) Cased to 1150, Size 2"
- (5) Screen: Size 2", Length 5 ft.
- (6) Were any formations sealed against pollution?
no

If YES depth of formation _____
Why _____

Drillers Remarks: _____

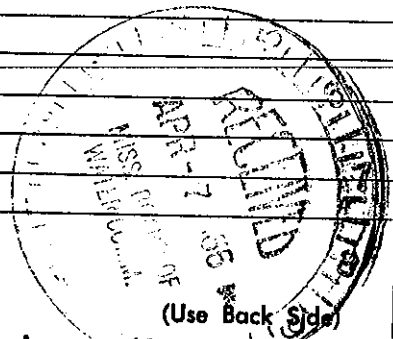

Well No. 6

(Use Back Side)