

FORREST MISSISSIPPI BOARD OF WATER COMMISSIONERS

E 15 ⑤

Q?

8-25-61

WATER WELL DRILLERS LOG

Date: 8-25, 1961, Driller: HERMON PARKER County FORREST
(Name)

(1) Owner of Land: <u>J. E. King</u> (Name)	Description & Color of Materials Sand, Clay, Red Clay, Shell, etc.	Thick- ness Feet	Depth Feet
<u>Rt. 2 HATTIESBURG, MISS</u> (Address)			
(2) Location: <u>1/4, 1/4, Sec. 18 T. 12 N.</u> <u>3</u> miles <u>EAST</u> , of <u>HATTIESBURG</u> (distance) (direction) (Nearest Town)	<u>CHALK</u>	<u>9</u>	<u>9</u>
(3) Topography: <u>FLAT</u> (Hilly) (Flat) (Level)	<u>SAND</u>	<u>33</u>	<u>42</u>
(4) Purpose of Well: <u>DOMESTIC</u> (Domestic Irrigation Municipal, Industrial, Other)			


Information upon completion of well:

- (1) Diameter 2 inches.
- (2) Total Depth 42 feet.
- (3) Water Level 9 feet below top of ground.
- (4) Cased to 42', Size 2"
- (5) Screen: Size 2", Length 5'
- (6) Were any formations sealed against pollution?
_____ yes, no.

If YES depth of formation _____

Why _____

Drillers Remarks: _____

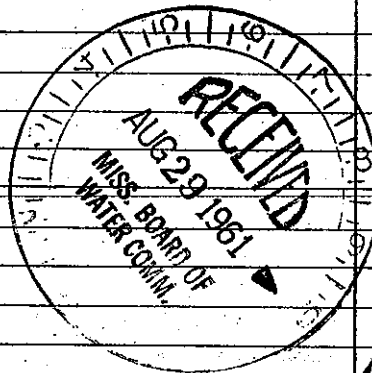

(Use Back Side)

Well No. 32

Mail this copy to Board of Water Commissioners 429 Miss. St. Jackson, Miss.