

FORREST MISSISSIPPI BOARD OF WATER COMMISSIONERS

E 18 ⑤

10-8-62

WATER WELL DRILLERS LOG

Date: 10-8, 1962, Driller: Fernon Park County Forrest
(Name)

(1) Owner of Land:	Description & Color of Materials Sand, Clay, Red Clay, Shell, etc.	Thick- ness Feet	Depth Feet
C.W. Reeves (Name) <u>Petal</u> (Address)	<u>Blue Clay</u>	<u>19</u>	<u>10</u>
(2) Location: <u>1/4</u> , <u>1/4</u> , Sec. <u>3</u> T. <u>R.</u>	<u>Sand</u>	<u>22</u>	<u>42</u>
<u>1</u> miles <u>South</u> of <u>Petal</u> (distance) (direction) (Nearest Town)			
(3) Topography: <u>Flat</u> (Hilly) (Flat) (Level)			
(4) Purpose of Well: <u>Domestic</u> (Domestic Irrigation Municipal, Industrial, Other)			


Information upon completion of well:

- (1) Diameter 2 inches.
- (2) Total Depth 42 feet.
- (3) Water Level 18 feet below top of ground.
- (4) Cased to 42', Size 2"
- (5) Screen: Size 2", Length 5'
- (6) Were any formations sealed against pollution?
 yes, no.

If YES depth of formation _____

Why _____

Drillers Remarks: _____

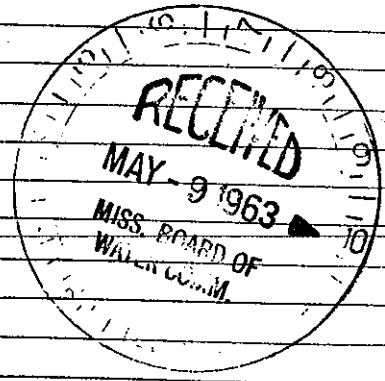

Well No. 42
510

(Use Back Side)