

FORREST MISSISSIPPI BOARD OF WATER COMMISSIONERS

E 19 ①

11-20-61

WATER WELL DRILLERS LOG

C-308

Date: 11-20, 1961, Driller: HERMODO PARKER County: FORREST

(Name)

(1) Owner of Land	Description & Color of Materials Sand, Clay, Red Clay, Shell, etc.	Thick- ness Feet	Depth Feet
MRS. WILLETTA HUDSON (Name)	RED CLAY	35	35
Rt. 2 HATTIESBURG MISS (Address)	WHITE CHALK	60	95
(2) Location: 1/4, 1/4, Sec 5 T4N R17W		32	127
2 miles EAST of HURG (distance) (direction) (Nearest Town)			
(3) Topography: levee (Hilly) (Flat) (Level)			
(4) Purpose of Well: DOMESTIC (Domestic Irrigation Municipal, Industrial, Other)			


Information upon completion of well:

- (1) Diameter 2 inches.
- (2) Total Depth 127 feet.
- (3) Water Level 67 feet below top of ground.
- (4) Cased to 127, Size 2"
- (5) Screen: Size 2", Length 5'
- (6) Were any formations sealed against pollution?
 yes, no.

If YES depth of formation _____

Why _____

Drillers Remarks: _____

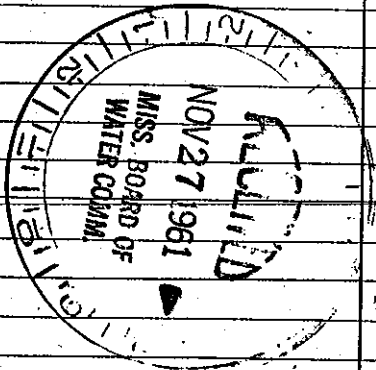

39

Well No.

(Use Back Side)

Mail this copy to Board of Water Commissioners 429 Miss. St. Jackson, Miss