

FORREST
E 21 0
10-7-62

BOARD OF WATER COMMISSIONERS

WATER WELL DRILLERS LOG

Date: 10-7, 1962, Driller: Herman Parker County Forrest
(Name)

(1) Owner of Land: J. R. Motes
(Name)
1712 Hallsburg
(Address)

Description & Color of Materials
Sand, Clay, Red Clay, Shell, etc.

Thick-
ness
Feet

Depth
Feet

Red Clay
Sand
35 35
51 86

(2) Location: 1/4, 1/4, Sec. 9 T. R

3 miles East of Hibery
(distance) (direction) (Nearest Town)

(3) Topography: Hilly
(Hilly) (Flat) (Level)

(4) Purpose of Well: Domestic
(Domestic Irrigation
Municipal, Industrial, Other)

Information upon completion of well:

(1) Diameter 2 inches.

(2) Total Depth 86 feet.

(3) Water Level 41 feet below top of ground.

(4) Cased to 86', Size 2"

(5) Screen: Size 2", Length 5'


(6) Were any formations sealed against pollution?

no

If YES depth of formation _____

Why _____

Drillers Remarks: _____

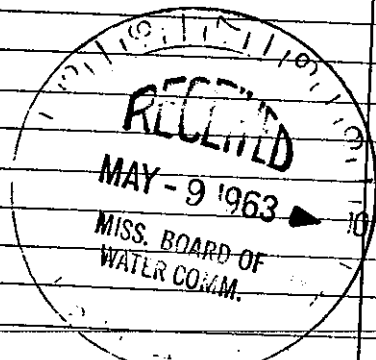

86
55 Well No.

(Use Back Side)

Mail this copy to Board of Water Commissioners 429 Miss. St. Jackson, Mis