

FORREST
E 22
3-68

MISSISSIPPI
BOARD OF WATER COMMISSIONERS
416 North State Street
Jackson, Mississippi 39201
WATER WELL DRILLERS LOG

3/19 1968 STR FORREST
date well completed firm name county well located


LANDOWNER: Mrs Ben Davis
Pt 1
Hattiesburg, Miss
(mailing address)

WELL LOCATION:
sec. 18 T. 4 N. R. 12 E
S W
1 miles SE of PETA
(distance) (direction) (nearest town)

WELL PURPOSE: Home
(home, irrigation, municipal, industrial)

WELL COMPLETION DATA:
(1) diameter (inches) 2"
(2) total depth (feet) 112
(3) static water level (feet) 46 below top of ground.
(4) casing 2" (material) 102 (depth)
2" (size) If telescope see back.
(5) screen 10 ft (length) 102 (depth to top)
2" (size) PLAST (material)
(6) pump 1 HP (HP) 540 W (field spec)
let (type power)
(7) electric log no (yes or no)
None (organization running log)
(8) how well bottom plugged Johnson

description of formations encountered	from	to
Red clay	0	10
Fine sand	10	20
St. P. sand	20	60
pink clay	60	70
fine sand	70	90
C W S sand	90	112

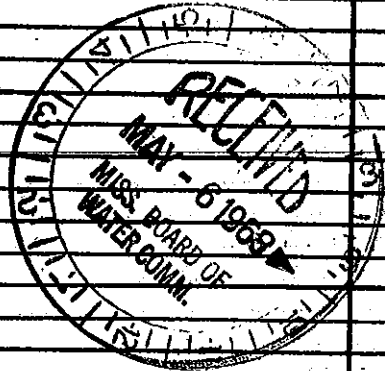

DRILLERS REMARKS: