

FOAREST  
E 23  
4-68

MISSISSIPPI  
BOARD OF WATER COMMISSIONERS  
416 North State Street  
Jackson, Mississippi 39201

WATER WELL DRILLERS LOG

4/20 1968 GTR Forest  
date well completed firm name county well located


LANDOWNER: Summie Bro  
RT 7  
Hattiesburg, Miss  
(mailing address)

description of formations encountered	from	to
Surface Clay	0	20
White Sand	20	30
white clay	30	50
Fine Sand	50	90
P w B Sand	90	110

WELL LOCATION:  
sec. 17 T. 4 N. R. 12 E.  
3 miles SE of Houma  
(distance) (direction) (nearest town)

WELL PURPOSE: Home  
(home, irrigation, municipal, industrial)

- WELL COMPLETION DATA:
- (1) diameter (inches) 2"
  - (2) total depth (feet) 110
  - (3) static water level (feet) 85' below above top of ground.
  - (4) casing plastic, 105'  
(material) (depth)  
2" If telescope see back.  
(size)
  - (5) screen 5 ft, 105'  
(length) (depth to top)  
2" plastic  
(size) (material)
  - (6) pump 1 600 hp  
(HP) (yield gpm)  
best  
(type power)
  - (7) electric log no  
(yes or no)  
none  
(organization running log)
  - (8) how well bottom plugged value

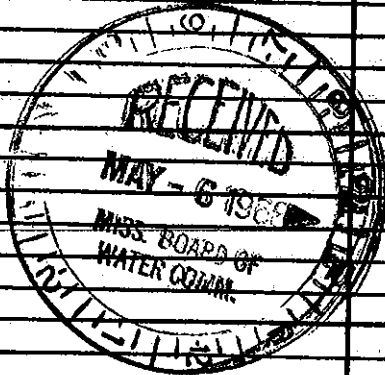

DRILLERS REMARKS: