

FORREST  
E 24  
2-68

MISSISSIPPI  
BOARD OF WATER COMMISSIONERS  
416 North State Street  
Jackson, Mississippi 39201

WATER WELL DRILLERS LOG

Feb 26 1968 date well completed  
STR firm name  
Forrest county well located

LANDOWNER: Lewis Rummel

description of formations encountered	from to	
Clay	0	10
Fine Sand	10	20
Shale	20	30
Fine Sand & Clay	30	40
Fine white sand	40	70
Coarse WBS	70	90


Petal Miss (mailing address)

WELL LOCATION:  
sec. 28 T 4 N R 12 E W S  
6 miles SE of Hattiesburg (distance) (direction) (nearest town)

WELL PURPOSE: Home (home, irrigation, municipal, industrial)

WELL COMPLETION DATA:

- (1) diameter (inches) 4"
- (2) total depth (feet) 90
- (3) static water level (feet) 48 below top of ground.
- (4) casing PVC 85' (material) (depth)  
4" (size) if telescope see back.
- (5) screen 5 ft, 85 ft (length) (depth to top)  
4" (size) PVC (material)
- (6) pump 1/3 (HP) 1200 gpm (yield gpm)  
Elec. (type power)
- (7) electric log no (yes or no)
- (8) how well bottom plugged Valve

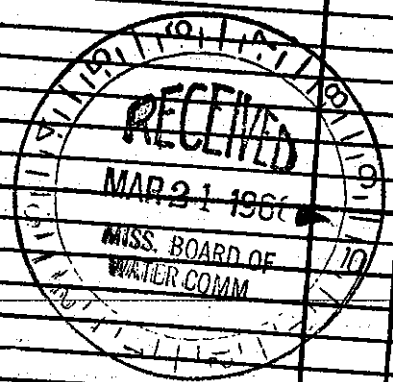

DRILLERS REMARKS: