

MISSISSIPPI BOARD OF WATER COMMISSIONERS

FORREST
E35
8-8-62

WATER WELL DRILLERS LOG

CODED

Date: 8-8-62, 1962, Driller: M. H. Moore County: Forrest
(Name)

(1) Owner of Land:	Description & Color of Materials Sand, Clay, Red Clay, Shell, etc.	Thick- ness Feet	Depth Feet
<u>Lois F White</u> (Name) <u>Walthburg Miss</u> (Address)	<u>Clay & Surface</u> <u>Sand Hard</u>	<u>16</u> <u>10</u>	
(2) Location: <u>1/4</u> , <u>1/4</u> , Sec. <u>10</u> T <u>9</u> R <u>12</u> <u> </u> miles <u> </u> of <u> </u> (distance) (direction) (Nearest Town)			
(3) Topography: <u> </u> (Hilly) (Flat) (Level)			
(4) Purpose of Well: <u>House use</u> (Domestic Irrigation Municipal, Industrial, Other)			

CODED


Information upon completion of well:

- (1) Diameter 2' inches.
- (2) Total Depth 26.00 feet.
- (3) Water level 16 feet below top of ground.
- (4) Cased to 21, Size 2"
- (5) Screen: Size 2", Length 5'
- (6) Were any formations sealed against pollution?
 yes, no.

If YES depth of formation

Why

Drillers Remarks:

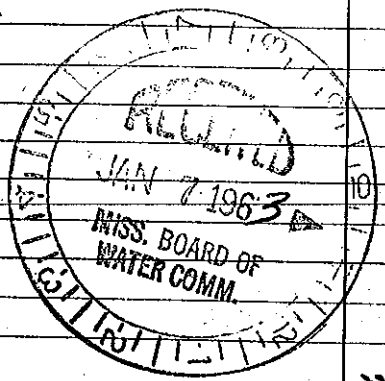

Well No.

(Use Back Side)