

FORREST
E36
1-17-63

MISSISSIPPI BOARD OF WATER COMMISSIONERS

WATER WELL DRILLERS LOG

CODED

Date: 1-17, 1963, Driller: Mr. N. Moore County Franklin

(Name)

(1) Owner of Land:	Description & Color of Materials Sand, Clay, Red Clay, Shell, etc.	Thick- ness Feet	Depth Feet
(Name) <u>Mr. J. Barnett</u>	<u>Superf. 0</u>	<u>10</u>	
(Address) <u>R 2, Hattiesburg</u>	<u>Sand 10</u>	<u>12</u>	
(2) Location: <u>Indian Spring Church Com.</u>	<u>Clay 12</u>	<u>112</u>	
1/4, 1/4, Sec. <u>9</u> T. <u>4R12</u>	<u>Sand & Shell 112</u>	<u>147</u>	
(3) Topography: <u>✓</u>			
(4) Purpose of Well: <u>Household</u>			

Information upon completion of well:

- (1) Diameter 2 inches.
- (2) Total Depth 147 feet.
- (3) Water Level 91 feet below top of ground.
- (4) Cased to _____, Size _____.
- (5) Screen: Size 2', Length 6.
- (6) Were any formations sealed against pollution?
_____ yes, ✓ no.


If YES depth of formation _____

Why _____

Drillers Remarks: _____

We had 56 feet of water for chicken house purpose

CODED

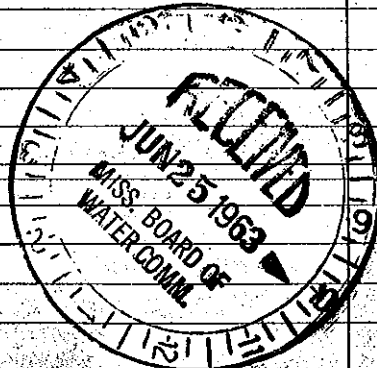

(Use Back Side)

Well No. 11