

FORREST

MISSISSIPPI BOARD OF WATER COMMISSIONERS

E 37

WATER WELL DRILLERS LOG

CODED

7-27-66

Date: 7/27, 1966, Driller: Hattiesburg Butane County Forrest

(Name)

(1) Owner of Land: Mack Rigdon
(Name)
Rt. 2, Hattiesburg, Miss.
(Address)

(2) Location: 1/4, 1/4, Sec. 16 T 9 R 12
miles of
(distance) (direction) (Nearest Town)

(3) Topography: level
(Hilly) (Flat) (Level)

(4) Purpose of Well: domestic
(Domestic Irrigation
Municipal, Industrial, Other)

Description & Color of Materials Sand, Clay, Red Clay, Shell, etc.	Thick- ness Feet	Depth Feet
red clay		0-12
white clay		12-60
red sand		60-90
blue clay		90-152
blue sand		152-190


Information upon completion of well:

- (1) Diameter 2 inches.
- (2) Total Depth 190 feet.
- (3) Water Level 65 feet below top of ground.
- (4) Cased to _____, Size _____
- (5) Screen: Size 2", Length 10
- (6) Were any formations sealed against pollution?
yes, no.

CODED

If YES depth of formation _____
Why _____

Drillers Remarks: _____

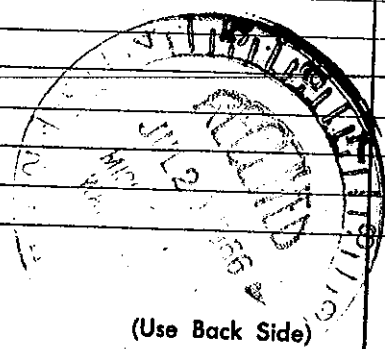

(Use Back Side)

Well No.