

State Well Report

Part 1

Mississippi Department of Environmental Quality
Office of Land and Water Resources
P.O. Box 10631
Jackson, MS 39289-0631
(601)961-5210
(601)354-6938 (fax)

County: Forsyth
Permit #: _____
Driller: Travis Boone
Date drilling completed: 3-14-05

For Office Use Only:
Aquifer: _____
Well #: E-66
L. S. Elevation: _____
B-log #: _____

State Law requires that this report be prepared by the driller in detail and filed with the Department within 30 days of completion of drilling of the well.

Well Owner Information	Well Location
Owner Name: <u>R. B. E. Oles</u>	Latitude: <u>31° 15' 48"</u> Longitude: <u>89° 12' 17"</u>
Mailing Address: <u>794 Old River Rd</u> <u>Petal, ms</u> <u>39465</u>	Method of Lat/Long (circle one): Conventional Survey, USGS quad, Hand-held GPS, Survey-grade GPS <u>NE 4 SW 4 Sec. 33 Twn 4N Rng 12W</u>
City: _____ State: _____ Zip Code: _____	Distance: <u>3 1/2</u> Miles Direction: <u>SE</u> of Nearest Town: <u>Hattiesburg</u>
Telephone No. <u>(601) 583-2094</u>	
Well Data	
Purpose of Well (circle one): <u>Home</u> Industrial Public Supply Irrigation Fish Culture Other: _____	
Date well drilling started: <u>3-14-05</u> Date well drilling completed: <u>3-14-05</u>	
If flowing, method of flow regulation: Valve _____ Other (describe): _____	
Static Water Level: <u>25</u> feet above or <u>below</u> (circle one) land surface Date measured: <u>3-14-05</u>	
Method of Measurement (circle one): steel tape electric tape air line other: <u>stilling line</u>	
Hole depth: _____ Well depth: <u>55 ft</u> Well grouted to a depth of <u>10</u> feet	
Type of grout (circle one): <u>Cement</u> Bentonite Mix	
Casing length: <u>45</u> feet Casing diameter: <u>4</u> inches Type of casing: <u>sch 40</u>	
Screen length: <u>10</u> feet Screen diameter: <u>4</u> inches Type of screen: <u>sch 40</u>	
Screen slot size: <u>8</u> inches Setting depth: From <u>45</u> feet to <u>55</u> feet	
Type of completion (circle all applicable): <u>Gravel packed</u> Undreamed Telescoped Open hole Natural Development Other (describe): _____	
Top of lap pipe or reduction in casing: _____ feet. If telescoped or more than one screen, describe on back of page	
Logs run (circle all applicable): <u>No log run</u> Electric Gamma Ray Density Sonic Neutron Other: _____	
Name of organization running log(s): _____	
I certify that the well was drilled, constructed, and completed in accordance with all applicable requirements of the Mississippi Department of Environmental Quality and/or the Mississippi Department of Health regulations and state laws.	
Print Name of Water Well Contractor and License No. <u>TRAVIS BOONE 0-514</u>	Signature of Water Well Contractor <u>Travis Boone</u>

RECEIVED

APR 13 2005


BY: OLWR

APR-13-2004 08:06A FROM:

E-66

If well telescopes please sketch below and show depths.

Ground Level

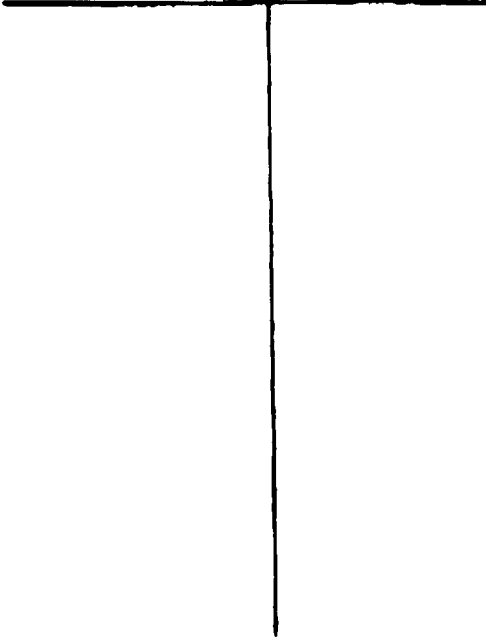

Description of Formations Encountered

From To

Description of Formations Encountered	From	To
clay	0	15
sand + gravel	15	55

If more than one screen, show location of each on sketch

Sketch the property layout and include the following: 1) the well location; 2) any permanent structures on the property that may aid in locating the well; 3) any roads, power lines, or other items that may aid in locating the property and the well; 4) indicate direction.

Landowner Name: RBE Davis

Maude Brown
 Signature of Water Well Contractor

RECEIVED

APR 13 2005

BY: OLWR

STATE WELL REPORT

Part 2

Pump Installer's Completion Report
 Mississippi Department of Environmental Quality
 Office of Land and Water Resources
 P.O. Box 10631
 Jackson, MS 39289-0631
 (601)961-5210
 (601)354-6938 (fax)

County: Forrest
 Permit #: _____
 Driller: Travis Boone
 Date completed: 3-14-05

For Office Use Only:

Aquifer: _____
 Well #: E-66
 Elevation: _____

This report should be prepared by the pump installer in detail and filed with the Department within 30 days of the installation of pump.

Well Owner Information	Well Location
Owner Name: <u>R.B. Ellis</u> Mailing Address: <u>794 Old River Rd.</u> <u>Petal, Ms.</u> <u>39465</u> <small>City State Zip Code</small> Telephone No. <u>(601) 583-2094</u>	Latitude: _____ Longitude: _____ Method of Lat/Long (circle one): <u>Conventional Survey</u> USGS quad, Hand-held GPS, Survey-grade GPS <u>1/4 Sec. 33 Twn 4N Rng 12W</u> Distance Direction Nearest Town <u>3/4 Miles SE of Hattiesburg</u>

Pump Type Circle one	Power Type Circle one
Air Lift <input type="checkbox"/> Jet <input type="checkbox"/> <u>Submersible</u> Bucket <input type="checkbox"/> Piston <input type="checkbox"/> Turbine <input type="checkbox"/> Centrifugal <input type="checkbox"/> Rotary <input type="checkbox"/> Flowing Well <input type="checkbox"/> Other (specify): _____ Date Pump Installed: <u>3-14-05</u> Rated Pump Capacity: _____ Gallons Per Minute	Diesel Engine <input type="checkbox"/> Gasoline Engine <input type="checkbox"/> Natural Gas <input type="checkbox"/> <u>Electric Motor</u> <input type="checkbox"/> Hand <input type="checkbox"/> Tractor PTO <input type="checkbox"/> Windmill <input type="checkbox"/> Other (specify): _____ Horse Power Rating of Motor: <u>1</u> Setting Depth: <u>45</u> feet Number of Stages: _____

Pump Test Data	Method of Measuring Water Level Circle one
Date Well Tested: <u>3-14-05</u> Static Water Level (A): <u>25</u> Feet Below Land Surface Pumping Water Level (B): _____ Feet Below Land Surface Drawdown [(B) - (A)]: _____ Feet Below Land Surface Test Pumping Rate: _____ Gallons Per Minute Duration of Pump Test (minimum 4 hours): _____ hours	Air Line <input type="checkbox"/> Electric Measuring Line <input type="checkbox"/> Steel Tape <input type="checkbox"/> Other (specify): <u>string line</u> For flowing well, measured shut in head: _____ feet Well yielded _____ GPM with a drawdown of _____ feet after _____ hours of pumping

I HEREBY CERTIFY that the above statements are true to the best of my knowledge.

Travis Boone 0-514 Travis Boone
Print Name of Pump Installer and License No. (if applicable) Signature of Pump Installer

RECEIVED

APR 13 2005

BY: OLWR