

Forrest

F 22

9-66

MISSISSIPPI BOARD OF WATER COMMISSIONERS

(6)

WATER WELL DRILLERS LOG

Date: 9-3, 1966, Driller: F.C. Drilling Co., County: Forrest
104 Thompson Blvd. (Name) (Address)

(1) Owner of Land	Description & Color of Materials Sand, Clay, Red Clay, Shell, etc.	Thick- ness Feet	Depth Feet
Jimmie Thompson (Name) Elks Lodge Property (Address)	hard clay	20	20
29-3243	Red clay	15	35
28-30134	fine sand	10	45
	hard sand	20	65

(2) Location: 1/4, 1/4, Sec. 28 T30N R13W
8 miles S.W. of Hattiesburg
(distance) (direction) (Nearest Town)

(3) Topography: Hilly
(Hilly) (Flat) (Level)


(4) Purpose of Well: Home
(Domestic Irrigation
Municipal, Industrial, Other)

Information upon completion of well:

- (1) Diameter 2 inches.
- (2) Total Depth 65 feet.
- (3) Water Level 23 feet below top of ground.
- (4) Cased to 60, Size 2"
- (5) Screen: Size 2", Length 5 ft.
- (6) Were any formations sealed against pollution?
yes, no.

If YES depth of formation _____
Why _____

Drillers Remarks: _____

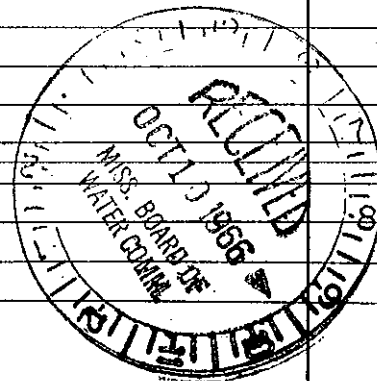

(Use Back Side)

Well No.