

FORREST MISSISSIPPI BOARD OF WATER COMMISSIONERS

24 ③
8-23-60

WATER WELL DRILLERS LOG

Date: 8/23, 1960, Driller: T. J. S. County: FORREST

(Name)

(1) Owner of Land: O. S. EXTINE
(Name)
RT 6 HATTIESBURG
(Address)

Description & Color of Materials
Sand, Clay, Red Clay, Shell, etc.

Thick-
ness
Feet

Depth
Feet

Sandy Clay Red 0-48
Sandy Clay 48-87
white

(2) Location: SE 1/4, NW 1/4, Sec. 23 T 32 R 2 E
3 N 13
8 miles S, of HATTIESBURG
(distance) (direction) (Nearest Town)

(3) Topography: HILLY
(Hilly) (Flat) (Level)

(4) Purpose of Well: HOME
(Domestic Irrigation
Municipal, Industrial, Other)

Information upon completion of well:

(1) Diameter 2 inches.


(2) Total Depth 87 feet.

(3) Water Level 52 feet below top of ground.

(4) Cased to 81, Size 2"

(5) Screen: Size 2", Length 5 FT.

(6) Were any formations sealed against pollution?
_____ yes, no.

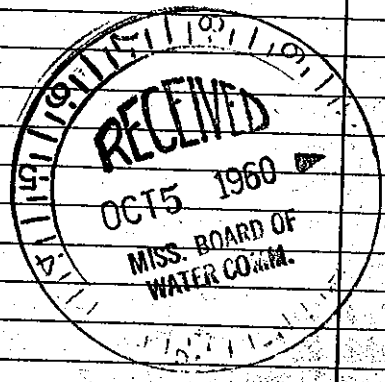

If YES depth of formation _____

Why _____

Drillers Remarks: _____

Well No.

(Use Back Side)

Copy to Board of Water Commissioners 429 Miss. St. Jackson, Miss.