

CODED

MISSISSIPPI
BOARD OF WATER COMMISSIONERS
416 North State Street
Jackson, Mississippi 39201

WATER WELL DRILLERS LOG

Forest
F. 28
7-68

July 9 1968 Anderson & Son South Saint
date well completed firm name county well located

LANDOWNER	description of formations encountered	from	to
J. A. Howell 2904 Meares Dr. Hattiesburg, Miss (mailing address)	White, Red & Blue Clay	0	60'
	fine gray sand	60'	65'
	coarse sand & pea gravel	65'	110'


WELL LOCATION:

sec 36 T-3 N R-13 E
12 miles South of Hattiesburg
(distance) (direction) (nearest town)

WELL PURPOSE: Home
(home, irrigation, municipal, industrial)

WELL COMPLETION DATA:

- (1) diameter (inches) 6 1/2"
- (2) total depth (feet)
- (3) static water level (feet) 21' below top of ground
- (4) casing 4" PVC 91'3"
(material) (depth)
If telescope see back.
(size)
- (5) screen 10'6"
(length) (depth to top)
4" 9.10 PVC
(size) (material)
- (6) pump 1 1/2 HP 1200 (yield gpm)
220 A.C.
(type power)
- (7) electric log No
(yes or no)
- (organization running log)
- (8) how well bottom plugged B.P.V.

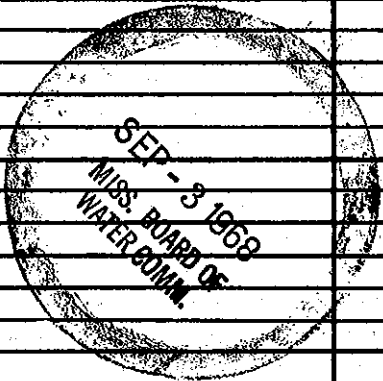

DRILLERS REMARKS:

Good Well