

FORREST
F 36

MISSISSIPPI BOARD OF WATER COMMISSIONERS

WATER WELL DRILLERS LOG

CODED

7-27-66

Date: 7/27, 1966, Driller: Hattiesburg, Butane County, Forrest
(Name)

(1) Owner of Land: <u>Lee Wilborn</u> (Name)	Description & Color of Materials Sand, Clay, Red Clay, Shell, etc.	Thick- ness Feet	Depth Feet
<u>Hattiesburg</u> (Address)	Red clay	0-10	
(2) Location: <u>1/4</u> , <u>1/4</u> , Sec. <u>2 T 3 R 13</u>	Red sand	10-70	
_____ miles _____ of _____ (distance) (direction) (Nearest Town)	Red clay	70-80	
(3) Topography: <u>Level</u> (Hilly) (Flat) (Level)	white clay	80-195	
(4) Purpose of Well: <u>domestic</u> (Domestic Irrigation Municipal, Industrial, Other)	blue sand	195-225	

Information upon completion of well:

(1) Diameter 2 inches.

(2) Total Depth 225 feet.

(3) Water Level 100 feet below top of ground.

(4) Cased to _____, Size _____

(5) Screen: Size 2", Length 10'


(6) Were any formations sealed against pollution?
_____ yes, X no.

If YES depth of formation _____

Why _____

Drillers Remarks: _____

CODED

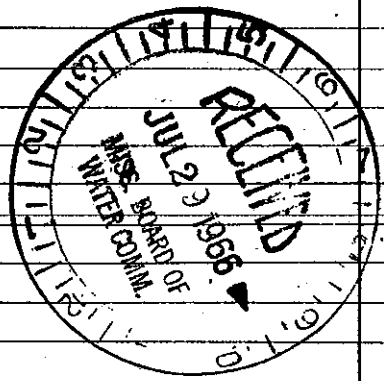

Well No. _____

(Use Back Side)