

Plugged and Abandoned

01987

Forrest  
F 43  
1176  
E 62 #128

MISSISSIPPI  
BOARD OF WATER COMMISSIONERS  
416 North State Street  
Jackson, Mississippi 39201

CODED


WATER WELL DRILLERS LOG

Jan. 19 76 GRINER DRILLING SERVICE FORREST  
date well completed firm name county well located

LANDOWNER: DIXIE WATER ASSN., WELL No. 2	description of formations encountered	from	to
(mailing address)	TOP SOIL	0	3
WELL LOCATION: NW 1/4 SE 1/4 NE 1/4 sec. 20 T. 3 N. R. 13 S	SAND	3	12
(distance) miles (direction) of (nearest town)	SANDY CLAY	12	16
WELL PURPOSE: (home, irrigation, municipal, industrial)	SAND	16	68
WELL COMPLETION DATA:	CLAY	68	100
(1) diameter (inches) 12 3/4	SAND + PEABLER	100	172
(2) total depth (feet) 164	CLAY	172	214
(3) static water level (feet) 88 below top of ground			
(4) casing (material) steel (depth) 118'			
12 3/4" (size) if telescope see back.			
(5) screen (length) 40' (depth to top) 124'			
8" (size) 304 S.S. (.010) (material)			
(6) pump (HP) 20 (yield gpm) 200			
elect. (type power)			
(7) electric log Yes (yes or no)			
M.G.S. (organization running log)			
(8) how well bottom plugged BACK			
DRILLERS REMARKS:			

CODED

Plugged and Abandoned

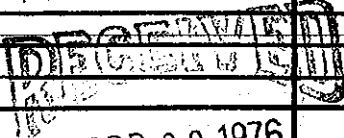

APR 30 1976

MISS. BD. OF WATER COMM