

# State Well Report

## Part 1

Mississippi Department of Environmental Quality  
Office of Land and Water Resources  
P.O. Box 10631  
Jackson, MS 39289-0631  
(601)961-5210  
(601)354-6938 (fax)

For Office Use Only:

Aquifer: \_\_\_\_\_  
Well #: F-63 35  
L. S. Elevation: \_\_\_\_\_  
E-log #: \_\_\_\_\_

County: Forrest  
Permit #: \_\_\_\_\_  
Driller: James Wells  
Date drilling completed: 10-4-04

State Law requires that this report be prepared by the driller in detail and filed with the Department within 30 days of completion of drilling of the well.

Well Owner Information	Well Location
Owner Name: <u>Oliver L Bryant</u>	Latitude: _____ " Longitude: _____ "
Mailing Address: <u>988 Elk Lake Rd</u>	Method of Lat/Long (circle one): <input type="radio"/> Conventional Survey,
<u>Hattiesburg MS</u>	<input type="radio"/> USGS quad, <input type="radio"/> Hand-held GPS, <input type="radio"/> Survey-grade GPS
<u>39401</u>	<u>N 1/4 SE 1/4 Sec 16 Twn 3N Rng 13W</u>
City State Zip Code	Distance Direction Nearest Town
Telephone No. <u>(601) 583-2983</u>	<u>5</u> Miles <u>South</u> of <u>Hattiesburg</u>

**Well Data**

Purpose of Well (circle one)  Home  Industrial  Public Supply  Irrigation  Fish Culture  Other: \_\_\_\_\_

Date well drilling started: 10-4-04 Date well drilling completed: 10-4-04

If flowing, method of flow regulation: Valve \_\_\_\_\_ Other (describe) 10-4-04

Static Water Level: 50 feet above or  below (circle one) land surface Date measured: \_\_\_\_\_

Method of Measurement (circle one)  steel tape  electric tape  air line  other: \_\_\_\_\_

Hole depth: 80 Well depth: 80 Well grouted to a depth of 10 feet

Type of grout (circle one)  Cement  Bentonite  Mix

Casing length: 66 feet Casing diameter: 4 inches Type of casing: PVC

Screen length: 20 feet Screen diameter: 4 inches Type of screen: 008 PVC

Screen slot size: 008 inches Setting depth: From 60 feet to 80 feet

Type of completion (circle all applicable):  Gravel packed  Underreamed  Telescoped  Open hole  Natural Development

Other (describe): \_\_\_\_\_

Top of lap pipe or reduction in casing: \_\_\_\_\_ feet. If telescoped or more than one screen, describe on back of page

Logs run (circle all applicable):  No log run  Electric  Gamma Ray  Density  Sonic  Neutron  Other: \_\_\_\_\_

Name of organization running log(s): \_\_\_\_\_

RECEIVED  
NOV 04 2004  
BY: OLWR

I certify that the well was drilled, constructed, and completed in accordance with all applicable requirements of the Mississippi Department of Environmental Quality and/or the Mississippi Department of Health regulations and state laws.

JAMES WELLS 0586 James Wells  
Print Name of Water Well Contractor and License No. Signature of Water Well Contractor

If well telescopes please sketch below and show depths.

Ground Level

F 63

Description of Formations Encountered


From To

Description of Formations Encountered	From	To
Top Soil	0	1
Red Clay	1	30
Sand	30	80

If more than one screen, show location of each on sketch

Sketch the property layout and include the following: 1) the well location; 2) any permanent structures on the property that may aid in locating the well; 3) any roads, power lines, or other items that may aid in locating the property and the well; 4) indicate direction.

RECEIVED  
NOV 04 2004  
BY: OLWR

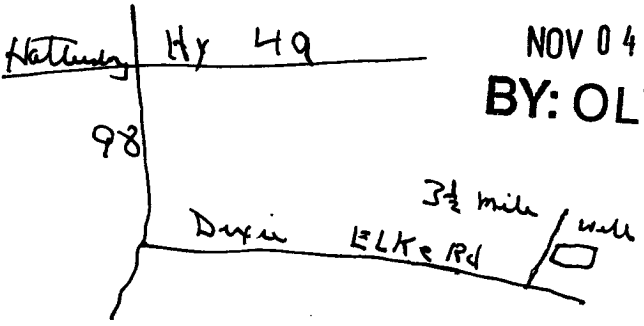

Landowner Name: Oliver Bryant

James Wells  
Signature of Water Well Contractor

# STATE WELL REPORT

## Part 2

**Pump Installer's Completion Report**  
 Mississippi Department of Environmental Quality  
 Office of Land and Water Resources  
 P.O. Box 10631  
 Jackson, MS 39289-0631  
 (601)961-5210  
 (601)354-6938 (fax)

**For Office Use Only:**

Aquifer: \_\_\_\_\_

Well #: F-63

Elevation: \_\_\_\_\_

County: Forrest  
 Permit #: \_\_\_\_\_  
 Driller: James Wells  
 Date completed: 10-4-04

**This report should be prepared by the pump installer in detail and filed with the Department within 30 days of the installation of pump.**

Well Owner Information	Well Location
Owner Name: <u>Oliver Bryant</u>	Latitude: _____ Longitude: _____
Mailing Address: <u>988 ELKS LANE RD</u>	Method of Lat/Long (circle one): Conventional Survey,
<u>Hattisburg</u>	USGS quad, Hand-held GPS, Survey-grade GPS
<u>MS 39401</u>	<u>N. 1/4 SE 1/4 Sec Twn 17W Rng 3N</u>
City State Zip Code	Distance Direction Nearest Town
Telephone No. <u>(601) 583-2983</u>	<u>5 Miles South of Hattisburg</u>

Pump Type Circle one	Power Type Circle one
Air Lift Jet <input type="radio"/> <u>Submersible</u>	Diesel Engine Gasoline Engine Natural Gas
Bucket Piston <input type="radio"/> Turbine <input type="radio"/>	<u>Electric Motor</u> Hand <input type="radio"/> Tractor PTO <input type="radio"/>
Centrifugal Rotary <input type="radio"/> Flowing Well <input type="radio"/>	Windmill Other (specify): _____
Other (specify): _____	Horse Power Rating of Motor: <u>1 HP</u>
Date Pump Installed: _____	Setting Depth: <u>70</u> feet
Rated Pump Capacity: _____ Gallons Per Minute	Number of Stages: <u>14</u>

RECEIVED  
 NOV 04 2004  
 BY: OLWR

Pump Test Data	Method of Measuring Water Level Circle one
Date Well Tested: _____	Air Line Electric Measuring Line <input type="radio"/> <u>Steel Tape</u>
Static Water Level (A): <u>50</u> Feet Below Land Surface	Other (specify): _____
Pumping Water Level (B): <u>70</u> Feet Below Land Surface	For flowing well, measured shut in head: _____ feet
Drawdown [(B) - (A)]: <u>50</u> Feet Below Land Surface	Well yielded <u>15</u> GPM with a drawdown of
Test Pumping Rate: <u>50</u> Gallons Per Minute	<u>50</u> feet after <u>4</u> hours of pumping
Duration of Pump Test (minimum 4 hours): <u>4</u> hours	

I HEREBY CERTIFY that the above statements are true to the best of my knowledge.

JAMES WELLS 0586 James Wells  
 Print Name of Pump Installer and License No. (if applicable) Signature of Pump Installer