

1151

Wilborn 2-11 #1

STATE WELL REPORT

Part 1

Driller's Log

Mississippi Department of Environmental Quality
Office of Land and Water Resources
P.O. Box 2309
Jackson, MS 39225-2309
(601)961-5210
(601)360-0535 (fax)

For Office Use Only:

Well #: F79
Aquifer: ☉
E-Log #: _____

County: Forrest
 Permit #: _____
 Driller: John W Thompson
 Date drilling completed: 10-3-15

State Law requires that this report be prepared by the license holder responsible for the work and filed with the Department at the above address within 30 days of completion of drilling of the well or borehole.

Well Owner Information <small>(Landowner if borehole is not for a water well)</small>			Well or Borehole Location	
Owner Name: <u>Pruett Production</u>			Latitude: <u>31°14' 60.0"</u> Longitude: <u>89°16' 27.0"</u>	
Mailing Address: <u>217 W Capital St</u> <u>Jackson MS 39201</u>			Method of Lat/Long (check one): Conventional Survey _____	
City _____ State _____ Zip Code _____			USGS quad _____, Hand-held GPS _____, Survey-grade GPS _____	
Telephone No. (____) _____			<u>NE</u> ¼ <u>SW</u> ¼, Sec <u>2</u> T. <u>3N</u> R. <u>13W</u>	
			<u>5</u> Miles <u>S</u> of <u>Hattiesburg</u>	
			(Distance) (Direction) (Nearest Town)	

Well / Borehole Data

Date drilling started: 10-1-15 Date drilling completed: 10-3-15 Hole depth: 600 Hole diameter: 7

Location of the source of any surface water used for drilling: Creek

Method of dosing and volume of Chlorine used in drilling and development: added 10 gallons of bleach

Logs run (circle all applicable): No log run Electric Gamma Ray Density Sonic Neutron Other: _____

Name of organization running log(s): _____

Purpose of borehole (circle one) Water Well Geotechnical/Geological Investigation Ground Source Heat Pump
Seismic Survey Other (describe) _____

If drilling is not related to water well construction, skip the remainder of this block

Purpose of Well (circle all applicable): Home Industrial Public Supply Irrigation Fish Culture

Other (describe): Fog supply

If a flowing well, method of flow regulation: Valve _____ Other (describe) _____

Static Water Level: 151 feet (above or below land surface) Date measured: 10-3-15
(circle one)

Method of measurement (circle one): Steel tape Electric tape Air line Other (describe): _____

Well depth: 300 Well grouted to a depth of: 20 feet Type of grout (circle one): Neat Cement Bentonite Mix

Casing length: 220 feet Casing diameter: 4 inches Type of casing: PVC

Screen length: 80 feet Screen diameter: 4 inches Type of screen: PVC slotted

Screen slot size: .010 inches Setting depth: From 180 feet to 260 feet
220 300

Type of completion (circle all applicable): Gravel packed Underreamed Open hole Natural Development

Other (describe): _____

Top of lap pipe or reduction in casing: _____ feet

If telescoped or more than one screen, describe on next page

County: _____

Permit #: _____


For Office Use Only:

Well #: **F79**

The sketch below only required for water wells

If well telescopes, show depths on sketch.

Ground Level →

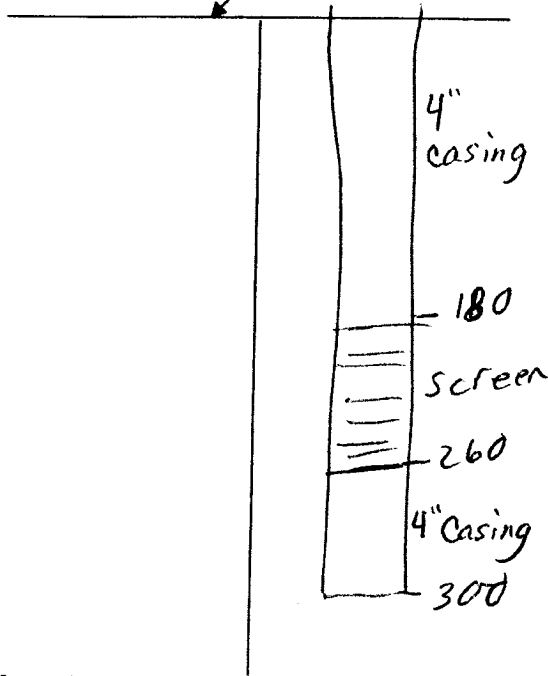

Description of formations encountered must be provided for all wells and boreholes, unless specifically exempted by regulations

Description of Formations Encountered	From (depth)	To (depth)
red sandy clay	Ground level	40
sand + gravel	40	65
clay	65	180
sand	180	200
fine sand + clay	200	260
clay	260	600

If more than one screen, show location of each on sketch

Sketch the property layout and include the following:

- 1) the well location
- 2) any permanent structures on the property that may aid in locating the well
- 3) any roads, power lines, or other items that may aid in locating the property and the well
- 4) north arrow

Landowner Name: Pruet

I HEREBY CERTIFY that the well/borehole was drilled, constructed, and completed in accordance with all applicable requirements of the Mississippi Department of Environmental Quality and the Mississippi Department of Health regulations, if applicable, and state laws.

John W Thompson 0-679

10-9-15


John W Thompson

Print Name of Responsible Licensee and License No.

Date

Signature of Licensee


Google Maps 31°14'60.0"N 89°16'27.0"W

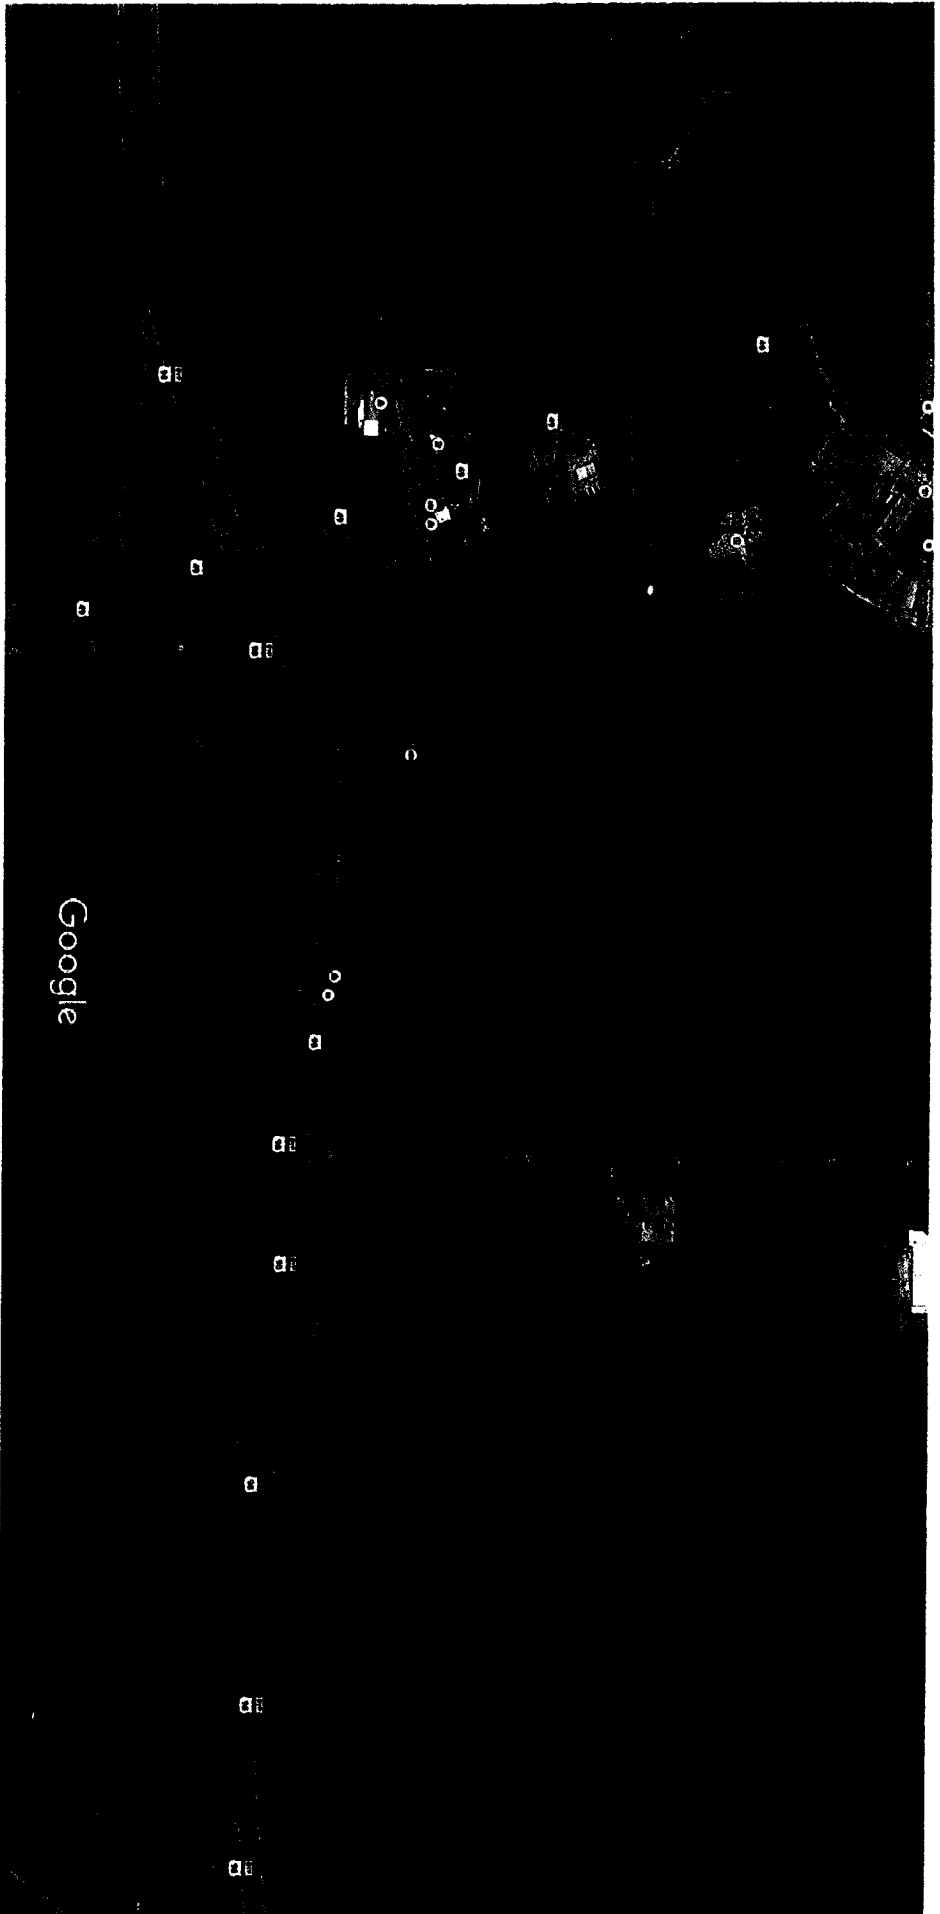

Imagery ©2015 DigitalGlobe, U.S. Geological Survey, USDA Farm Service Agency, Map data ©2015 Google 500 ft

Google

Google Maps 31°14'50.0"N 89°16'27.0"W

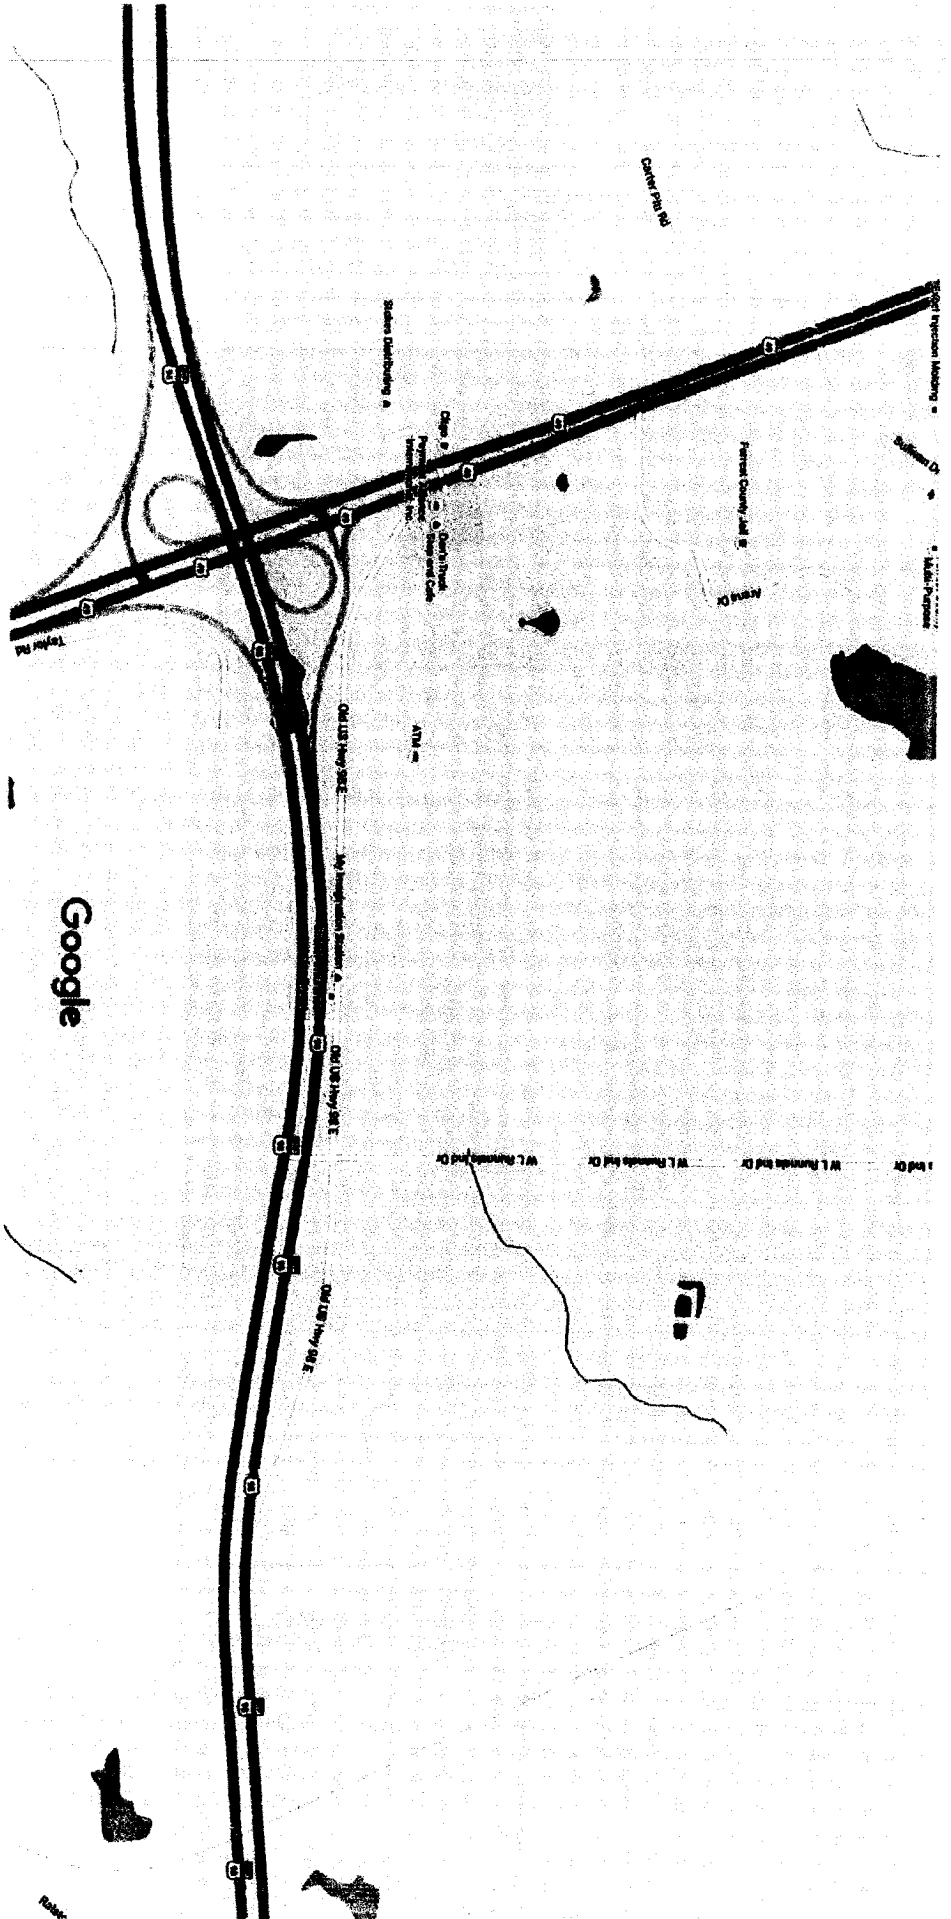

Map data ©2015 Google 500 ft

STATE WELL REPORT

Part 2

Pump Installer's Completion Report
 Mississippi Department of Environmental Quality
 Office of Land and Water Resources
 P.O. Box 2309
 Jackson, MS 39225-2309
 (601)961-5210
 (601) 360-0535 (fax)

For Office Use Only:

Well #: F
 Aquifer: _____

County: Forrest
 Permit #: _____
 Driller: John W Thompson
 Date completed: 10-3-15
Copy information from block on Part 1

This part of the report must be completed by a licensed water well contractor or a licensed pump installer. A copy of Part 1 of the report must be attached and both parts filed with the Department at the above address within 30 days of well completion.

Well Owner Information			Well Location		
Owner Name: <u>Kuet Production</u>			Latitude: <u>31°14'6.0"</u> Longitude: <u>89°16'27.0"</u>		
Mailing Address: <u>217 W Capital St</u> <u>Jackson MS 39201</u>			Method of Lat/Long (check one): Conventional Survey _____, USGS quad _____, Hand-held GPS <input checked="" type="checkbox"/> , Survey-grade GPS _____		
City	State	Zip Code	_____ 1/4 _____ 1/4, Sec <u>2</u> T <u>3N</u> R <u>13W</u>		
Telephone No. (____) _____			<u>5</u> Miles <u>S</u> of <u>Hattiesburg</u> (Distance) (Direction) (Nearest Town)		

Pump Type (circle one)

Submersible Turbine Air Lift Centrifugal Flowing Well Jet Piston Rotary Other (describe): _____

Date Pump Installed: 10-3-15 Rated Pump Capacity: 35 Gallons Per Minute

Is This Pump (circle one): New Repaired Replacement with drawdown seal

Power Type (circle one)

Electric Diesel Gasoline Natural Gas Tractor PTO Windmill Other (describe): _____

Horse Power Rating of Motor: 5 Setting Depth: 180 feet Number of Stages: _____

Pump Test Data for Non Flowing Well

Date Well Tested: 10-3-15 Duration of Pump Test (minimum 4 hours): _____ hours

Static Water Level (A): 151 Feet Below Land Surface Pumping Water Level (B): 175 Feet Below Land Surface

Drawdown [(B) - (A)]: 14 Feet Below Land Surface Test Pumping Rate: 45 Gallons Per Minute

Method of measurement (circle one): Steel tape Electric tape Air line Other (describe): _____

Pump Test Data for Flowing Well

Measured shut in head: _____ feet.

Well yielded _____ GPM with a drawdown of _____ feet after _____ hours of pumping

Meter Installation

Meter Manufacturer: _____ Meter Serial Number: _____

Meter Model Number/Name: _____ Type of Meter: _____

Totalizer Register Unit and Multiplier Factor (AF x .001, gal x 1000, etc): _____

Installation Date: _____ Meter installed by: _____

Is This Meter (circle one): New Repaired Replacement

Important: By submitting the above information you are certifying that this meter was installed to manufacturer standards. For agricultural wells, a list of approved meters is on the MDEQ website.

I HEREBY CERTIFY that the above statements are true to the best of my knowledge.

John W Thompson 0-679 10-9-15 John W Thompson
 Print Name of Pump Installer and License No. (if applicable) Date Signature of Pump Installer