

626 & 631 are same well

BW
01897

CODED

FORREST

MISSISSIPPI
BOARD OF WATER COMMISSIONERS
416 North State Street
Jackson, Mississippi 39201

Plugged and Abandoned

by Griner
10/5/99

626

7-26-67

M. G. S.

WATER WELL DRILLERS LOG

7-26 1967 Griner Drill. Inc. Forrest
date well completed firm name county well located

LANDOWNER: Mc. Lawin
Utilities Association

description of formations encountered	from	to
Top Soil	10'	10'
Sands & Gravel	274'	264'
Clay	382'	108'
Sand	418'	36'
Clay	465'	47'
Coarse Sand	550'	85'
Clay	580'	30'
Sand	632'	52'

(mailing address)

WELL LOCATION:

sec 32 T 3 N R 12 E
S W


(distance) miles (direction) of (nearest town)

WELL PURPOSE:

(home, irrigation, municipal, industrial)

WELL COMPLETION DATA:

- (1) diameter (inches) 6 5/8"
- (2) total depth (feet) 630'
- (3) static water level (feet) 206' below top of ground.
- (4) casing Steel, 574' (material) (depth)
658" (size) if telescope see back.
- (5) screen 40' 590' (length) (depth to top)
4" (size) S.S. (material)
- (6) pump 20 (HP) 110 (yield gpm)
E.L.C. (type power)
- (7) electric log Yes (yes or no)
Miss. G.S. (organization running log)
- (8) how well bottom plugged Back-Wash Valve

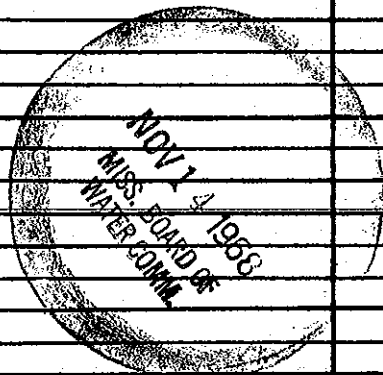

DRILLERS REMARKS: