

Forrest
G 27
10-66

MISSISSIPPI BOARD OF WATER COMMISSIONERS

3

WATER WELL DRILLERS LOG

Date: 10-28, 1966, Driller: J. P. Drilling Ser. County: Forrest

104 Thompson Blvd. (Name) Pittal miss

(1) Owner of Land: P. B. Creel (Name)

P.O. Box 6, Hattiesburg miss (Address)

(2) Location: NE 1/4, NW 1/4, Sec. 7 T24N R12W

6 miles south of Hattiesburg (distance) (direction) (Nearest Town)

(3) Topography: Hilly (Hilly) (Flat) (Level)

(4) Purpose of Well: Home (Domestic Irrigation Municipal, Industrial, Other)

Description & Color of Materials Sand, Clay, Red Clay, Shell, etc.	Thick- ness Feet	Depth Feet
hard + gravel	10	10
blue clay	90	100
fine sand	5	105
hard sand	10	115

Information upon completion of well:

(1) Diameter: 2 inches.

(2) Total Depth: 45 feet.

(3) Water Level: 15 feet below top of ground.

(4) Cased to: 40 ft, Size 2"


(5) Screen: Size 1/2", Length 5 ft.

(6) Were any formations sealed against pollution?
yes, no.

If YES depth of formation

Why

Drillers Remarks:

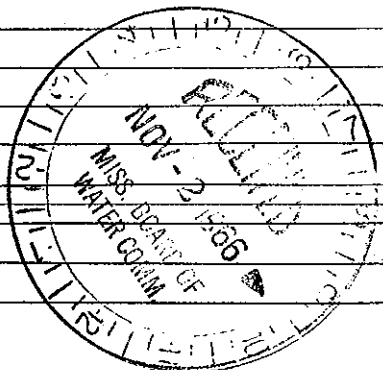

(Use Back Side)

Well No.

Mail this copy to Board of Water Commissioners 429 Miss. St. Jackson, Miss.