

FORREST MISSISSIPPI BOARD OF WATER COMMISSIONERS

G 21 6
7-23-62

WATER WELL DRILLERS LOG

Forrest

Date: 7-23, 1962, Driller: David Newell County Perry
(Name)

(1) Owner of Land: <u>Walter Mars</u> (Name)	Description & Color of Materials Sand, Clay, Red Clay, Shell, etc.	Thick- ness Feet	Depth Feet
<u>Sheeplow, Miss.</u> (Address)	<u>Red Clay</u>		<u>19</u>
(2) Location: <u>Withheld</u> ^{S_N} _T <u>15 3/4</u> <u>R/2</u>	<u>Chalk Clay</u>		<u>51</u>
<u>12</u> miles <u>West</u> , of <u>New Augusta</u> (distance) (direction) (Nearest town)	<u>Blue Sand</u>		<u>27</u>
(3) Topography: <u>Hilly</u> (Hilly) (Flat) (Level)			
(4) Purpose of Well: <u>Domestic</u> (Domestic Irrigation Municipal, Industrial, Other)			


Information upon completion of well:

- (1) Diameter 2 inches.
- (2) Total Depth 90 feet.
- (3) Water Level 40 feet below top of ground.
- (4) Cased to 2", Size 2".
- (5) Screen: Size 2", Length 6'.
- (6) Were any formations sealed against pollution?
_____ yes, X no.

If YES depth of formation _____

Why _____

Drillers Remarks: _____

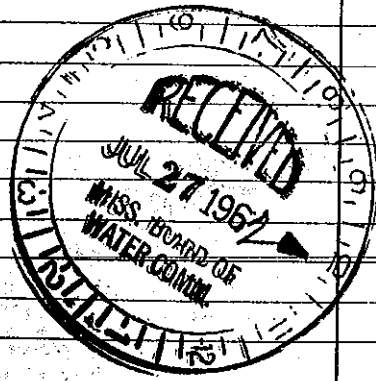

(Use Back Side)

Well No.

Mail this copy to Board of Water Commissioners 429 Miss. St. Jackson, Miss.