

Forrest MISSISSIPPI BOARD OF WATER COMMISSIONERS ?

H 2000 H

7-3-61

WATER WELL DRILLERS LOG

Date: 7-3, 1961, Driller: Hattiesburg Butane County Forrest

(Name)

(1) Owner of Land: C. F. Nardholm (Name)	Description & Color of Materials Sand, Clay, Red Clay, Shell, etc.	Thick- ness Feet	Depth Feet
Rt. 6 - Hattiesburg, Miss (Address)	Red Clay		15
(2) Location: _____ 1/4, _____ 1/4, Sec. _____ T. R. _____	white sand		15-20
_____ miles _____ of _____ (distance) (direction) (Nearest Town)	white clay		20-100
(3) Topography: Hilly (Hilly) (Flat) (Level)	white sand		100-110
(4) Purpose of Well: Domestic (Domestic Irrigation, Municipal, Industrial, Other)	white clay		110-140
	Blue clay		140-200
	Blue sand		200-210
	Blue clay + Blue sand		210-250
	Blue sand		250-300


Information upon completion of well:

- (1) Diameter 2 inches.
- (2) Total Depth 300 feet.
- (3) Water Level 8.4 feet below top of ground.
- (4) Cased to Bottom, Size 2"
- (5) Screen: Size 2", Length 10 ft.
- (6) Were any formations sealed against pollution?
_____ yes, X no.

If YES depth of formation _____

Why _____

Drillers Remarks: _____

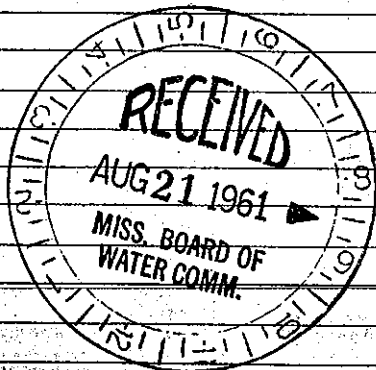

Well No.

(Use Back Side)

Mail this copy to Board of Water Commissioners 429 Miss. St. Jackson, Miss