

MISSISSIPPI BOARD OF WATER COMMISSIONERS


172001

WATER WELL DRILLERS LOG

Jarrest

Date: 12-20, 1965, Driller: Neil Lumpkin County: P.R.
(Name)

(1) Owner of Land:	Description & Color of Materials Sand, Clay, Red Clay, Shell, etc.	Thick- ness Feet	Depth Feet
Elks Lake Country Club (Name) Hathesburg Route (Address)	Surface clay	0	10
	" sand "mucky"	10	53
	Blue clay	53	280
	fine to better sand	280	326
(2) Location: 1/4, 1/4, Sec. T R			
15 miles S/E, of Hathesburg (distance) (direction) (Nearest Town)			
(3) Topography: Hilly (Hilly) (Flat) (Level)			
(4) Purpose of Well: (Domestic Irrigation Municipal, Industrial, Other)			
Information upon completion of well:			
1 joint 6" casing 21'			
(1) Diameter 4 inches.			
(2) Total Depth 326 feet.			
(3) Water Level 90 feet below top of ground.			
(4) Cased to _____, Size _____			
(5) Screen: Size 4" 12 gauge, Length 10'			
(6) Were any formations sealed against pollution?			
yes yes, _____ no.			
If YES depth of formation 21'			
Why: Their request well near a lake.			
Drillers Remarks:			

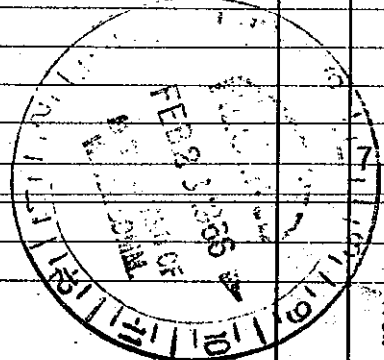

(Use Back Side)

Well No.

Mail this copy to Board of Water Commissioners 429 Miss. St. Jackson, Miss.