

Forrest
H 2006
7-8-81

MISSISSIPPI
BOARD OF WATER COMMISSIONERS
416 North State Street
Jackson, Mississippi 39201

WATER WELL DRILLERS LOG
BRADEN PUMP AND WELL SERVICE, INC.
7-8-81 ROUTE 1, BOX 480 FORREST
date well completed SAUCIER, MS 39574 county well located


LANDOWNER:
JULES B. SACHS
620 Gov. Nichols St.
New Orleans, LA 70116
(mailing address)

description of formations encountered	from	to
SAND	0	15
CLAY	15	35
SAND	35	60
CLAY	60	230
SAND	230	280

WELL LOCATION:
sec. 35 T. 20 N. R. 13 E
S 4
4 miles NW of Brooklyn
(distance) (direction) (nearest town)

WELL PURPOSE: home
(home, irrigation, municipal, industrial)

- WELL COMPLETION DATA:
- (1) diameter (inches) 4 1/2
 - (2) total depth (feet) 280
 - (3) static water level (feet) 50 below above top of ground.
 - (4) casing PVC, total! (material) (depth)
4 1/2 (size) if telescope see back.
 - (5) screen 10, 265 (length) (depth to top)
2" PVC underbar (size) (material)
 - (6) pump 1, 20 (HP) (yield gpm)
200 (type power)
 - (7) electric log NO (yes or no)
(organization running log)
 - (8) how well bottom plugged
2" SAND SHANK

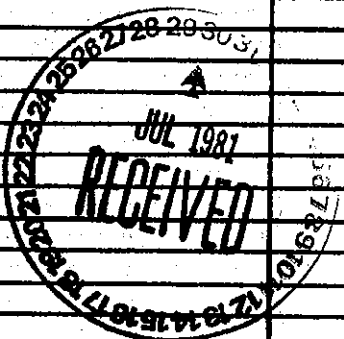

DRILLERS REMARKS:
5' tail pipe