

Forrest

MISSISSIPPI BOARD OF WATER COMMISSIONERS

T 11  
6-66

①

WATER WELL DRILLERS LOG

Date: 6/15, 1966, Driller: Forrest Drilling County Forrest

(1) Owner of Land State of Miss  
(Name)  
Ray B Johnson Park  
(Address)  
RR Hattisburg, Miss.

(2) Location:  $\frac{1}{4}$ ,  $\frac{1}{4}$ , Sec. 18 T2N R12W  
15 miles South of Hattisburg  
(distance) (direction) (Nearest Town)

(3) Topography: ✓  
(Hilly) (Flat) (Level)

(4) Purpose of Well: State Park  
(Domestic Irrigation  
Municipal, Industrial, Other)

Description & Color of Materials Sand, Clay, Red Clay, Shell, etc.	Thick- ness Feet	Depth Feet
<u>Soft Sand + Chalk</u>		<u>20</u>
<u>Chalk or fine Clay</u>		<u>143</u>
<u>Blue Chalk</u>		<u>225</u>
<u>Soft Shale</u>		<u>246</u>
<u>Hard + Sols Shale</u>		<u>257</u>
<u>Fine Sand</u>		<u>266</u>
<u>Sand + Shale</u>		<u>276</u>
<u>Fine Sand</u>		<u>286</u>
<u>Med. Sand</u>		<u>307</u>
<u>Coarse Sand</u>		<u>328</u>

Information upon completion of well:

(1) Diameter 4 inches.

(2) Total Depth 328 feet.

(3) Water Level 108 feet below top of ground.

(4) Cased to 303, Size 4"


(5) Screen: Size 4" N, Length 25ft

(6) Were any formations sealed against pollution?  
\_\_\_\_\_ yes, ✓ no.

If YES depth of formation \_\_\_\_\_

Why \_\_\_\_\_

Drillers Remarks: \_\_\_\_\_

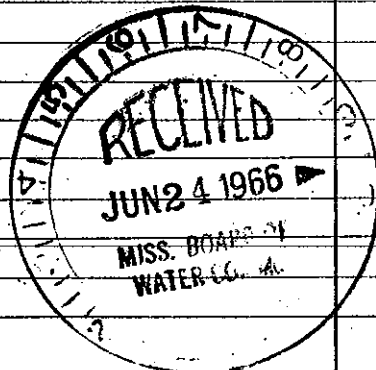

(Use Back Side)

Well No.

Mail this copy to Board of Water Commissioners 429 Miss. St. Jackson, Miss