

FORREST MISSISSIPPI BOARD OF WATER COMMISSIONERS

J 12 ⑤

11-25-64

WATER WELL DRILLERS LOG

Date: 11/25, 1964, Driller: Forrest Dilling ^{Sen} Forrest County: Scott
(Name)

(1) Owner of Land: <u>J.C. Basler</u> <small>(Name)</small>	Description & Color of Materials Sand, Clay, Red Clay, Shell, etc.	Thick- ness Feet	Depth Feet
<u>Rt 6 Hattisburg</u> <small>(Address)</small>	<u>Red Clay</u>	<u>0</u>	<u>8</u>
(2) Location: <u>1/4, 1/4, Sec. 17 T2R12W</u>	<u>Chalk</u>	<u>60</u>	
<u>South on 49</u>	<u>Chalky Mound</u>	<u>136</u>	
<u>1/4 mile East Shelby, of Hattisburg</u> <small>(distance) (direction) (Nearest Town)</small>	<u>Brn. Shale + Clay</u>	<u>163</u>	
(3) Topography: <u>State park</u>	<u>Blue Clay + Shale</u>	<u>206</u>	
<small>(Hilly) (Flat) (Level)</small>	<u>Shale</u>	<u>248</u>	
(4) Purpose of Well: <u>Home</u>	<u>Sand + Shale</u>	<u>269</u>	
<small>(Domestic Irrigation Municipal, Industrial, Other)</small>	<u>Coarse Sand + Shale</u>	<u>280</u>	
	<u>Fine Sand</u>	<u>304</u>	


Information upon completion of well:

- (1) Diameter 2 inches.
- (2) Total Depth 304 feet.
- (3) Water Level 105 feet below top of ground.
- (4) Cased to 294, Size 10 5/8" 2 1/2"
- (5) Screen: Size 2", Length 10ft
- (6) Were any formations sealed against pollution?
 yes, no.

If YES depth of formation _____

Why _____

Drillers Remarks: _____

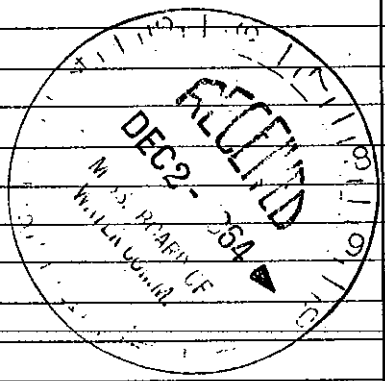

(Use Back Side)

Well No.