

FORREST MISSISSIPPI BOARD OF WATER COMMISSIONERS

J 13

10-23-61

WATER WELL DRILLERS LOG

J-300

Date: 10-23, 1961, Driller: HERMON PARKER County, FORREST

(Name)

(1) Owner of Land: <u>VIRGIL BOND</u> <small>(Name)</small>	Description & Color of Materials Sand, Clay, Red Clay, Shell, etc.	Thick- ness Feet	Depth Feet
<u>Brook 1 1/2 miles</u> <small>(Address)</small>	<u>CHALK</u>	<u>20</u>	<u>20</u>
(2) Location: <u>1/4, 1/4, Sec. 10 T. 21 N. R. 12 W.</u> <u>7 miles N-EAST, of BROOKLYN</u> <small>(distance) (direction) (Nearest Town)</small>	<u>SAND</u>	<u>70</u>	<u>90</u>
(3) Topography: <u>FLAT</u> <small>(Hilly) (Flat) (Level)</small>			
(4) Purpose of Well: <u>DOMESTIC</u> <small>(Domestic Irrigation Municipal, Industrial, Other)</small>			


Information upon completion of well:

- (1) Diameter 2 inches.
- (2) Total Depth 90' feet.
- (3) Water Level 43 feet below top of ground.
- (4) Cased to 90', Size 2"
- (5) Screen: Size 2", Length 5'
- (6) Were any formations sealed against pollution?
yes, NO no.

If YES depth of formation _____

Why _____

Drillers Remarks: _____

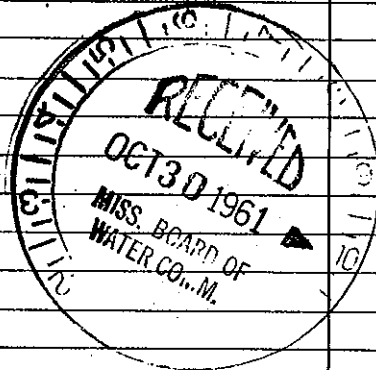

37

Well No.

(Use Back Side)

Mail this copy to Board of Water Commissioners 429 Miss. St. Jackson, Miss