

FORREST
 J 15
 4-68

MISSISSIPPI
 BOARD OF WATER COMMISSIONERS
 416 North State Street
 Jackson, Mississippi 39201

WATER WELL DRILLERS LOG

4/13 1968 STR Forrest
 date well completed firm name county well located


LANDOWNER: St Bennett
PT 1 (Blendale)
Hattiesburg, Miss
 (mailing address)

description of formations encountered	from	to
<u>Sandy Clay</u>	<u>0</u>	<u>23</u>
<u>fine sand</u>	<u>23</u>	<u>40</u>
<u>hard rock</u>	<u>40</u>	<u>41</u>
<u>Chalk rock</u>	<u>41</u>	<u>55</u>

WELL LOCATION:
 sec. 5 T. 2 N. R. 12 E
1 miles West of McLain
 (distance) (direction) (nearest town)

WELL PURPOSE: Home
 (home, irrigation, municipal, industrial)

- WELL COMPLETION DATA:
- (1) diameter (inches) 2"
 - (2) total depth (feet) 55 ft
 - (3) static water level (feet) 40 below above top of ground.
 - (4) casing plastic, 50,
 (material) (depth)
2"
 (size) if telescope see back.
 - (5) screen 5 ft, 50 ft
 (length) (depth to top)
2", plastic
 (size) (material)
 - (6) pump 1/2 360 GPM
 (HP) (yield-gpm)
1/2
 (type power)
 - (7) electric log no
 (yes or no)
None
 (organization running log)
 - (8) how well bottom plugged Value

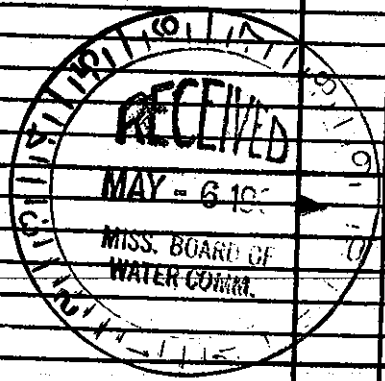

DRILLERS REMARKS: