

MISSISSIPPI DEPARTMENT OF ENVIRONMENTAL QUALITY
Bureau of Land and Water Resources

P. O. Box 10631
Jackson, MS 39289-0631
WATER WELL DRILLERS LOG

COUNTY WELL LOCATED Forrest	
WELL NUMBER J 2013	CODED
DATE WELL COMPLETED 2-15-92	

PERMIT NUMBER
NAME OF DRILLING FIRM Boone's Water Well

NAME & MAILING ADDRESS OF LANDOWNER Jack Phillips		
Old 49 East		
Nattiesburg, Ms		
WELL LOCATION: SEC	TOWNSHIP	RANGE
27	2	12
DISTANCE DIRECTION NEAREST TOWN 4 Miles N of Brooklyn		
OTHER LANDMARK		
WELL PURPOSE Home Irrigation, Municipal, Industrial, Fish Pond, etc.		

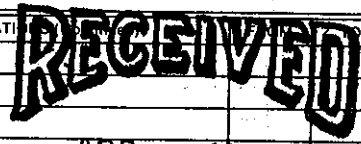
PUMP DATA		
PUMP TYPE (Circle One): <input checked="" type="checkbox"/> Submersible, Turbine, Jet, Flowing Well, Other (Describe)		
POWER TYPE (Circle One): <input checked="" type="checkbox"/> Electric, Tractor, Diesel, Gasoline, Butane, Other (Describe) H/P 1		
Pump Capacity (GPM)	No. of Stages	Setting Depth FT.
PUMP TEST		
Well yielded _____ GPM with		
a drawdown of _____ ft.		
after _____ hours of pumping		

WELL DATA		
Well Depth 250	Casing Diameter (In.) 4	Casing Length (Ft.) 230
Type of Casing sch 40	Hole Depth 250	Depth to Static Water Level
TYPE OF COMPLETION: (Circle One or More): <input checked="" type="checkbox"/> Gravel Packed, Underreamed, Telescoped, Natural Development, Open Hole, Other (Describe)		
Top of Lap Pipe or Reduction in Casing FEET IF TELESCOPED OR MORE THAN ONE SCREEN: USE BACK PAGE		

LOG DATA	
TYPE OF LOG RUN (Circle One): No Log Run, Electric, Gamma Ray, Density, Sonic, Neutron, Other (Describe)	
Name of Organization Running Log	

SCREEN DATA		
Diameter - Inches 4	Length - Feet 20	Slot Size - Inches 10
Screen Type sch 40	Depth to Bottom - Feet	

GEOLOGIC DATA (Office Use Only)			
Surface Elev.	Geologic Unit	Unit Thickness	Depth to Top
Subs. SWL	Date	Analysis	Aquifer Test
Driller's Remarks			

DESCRIPTION OF FORMATIONS ENCOUNTERED	FROM	TO	FORMAT
White Clay	0	60	<div style="text-align: center;">  APR 01 1992 Dept. of Environmental Quality Bureau of Land & Water Resources </div>
Sand	60	64	
Clay	64	120	
Sand	120	126	
Blue Clay	126	210	
Sand	210	212	
Blue Clay	212	230	
Sand	230	250	
IF MORE SPACE IS NEEDED, USE BACK			