

**FORREST MISSISSIPPI BOARD OF WATER COMMISSIONERS**

H-301  
Forrest  
~~Lawrence~~

K 2 ⑥  
6-61

**WATER WELL DRILLERS LOG**

Date: June, 1961, Driller: Leo Labner County: Lauderdale  
(Name)

(1) Owner of Land:	Description & Color of Materials Sand, Clay, Red Clay, Shell, etc.	Thick- ness Feet	Depth Feet
<u>AB Simmons</u> (Name)	<u>Red Clay</u>	<u>45</u>	<u>0-45</u>
<u>At #2 Purvis</u> (Address)	<u>Red sand</u>	<u>28</u>	<u>46-73</u>
(2) Location: <u>1/4</u> , <u>1/4</u> , Sec. <u>34</u> T. <u>7N</u> R. <u>3W</u>			
<u>10</u> miles <u>SE</u> of <u>Purvis</u> (distance) (direction) (Nearest Town)			
(3) Topography: <input checked="" type="checkbox"/> (Hilly) <input type="checkbox"/> (Flat) <input type="checkbox"/> (Level)			
(4) Purpose of Well: <u>Farm use</u> (Domestic Irrigation, Municipal, Industrial, Other)			


Information upon completion of well:

- (1) Diameter 2 inches.
- (2) Total Depth 73 feet.
- (3) Water Level 42 feet below top of ground.
- (4) Cased to 67, Size 2"
- (5) Screen: Size 008, Length 5'
- (6) Were any formations sealed against pollution?  
yes,  no.

If YES depth of formation \_\_\_\_\_

Why \_\_\_\_\_

Drillers Remarks: \_\_\_\_\_

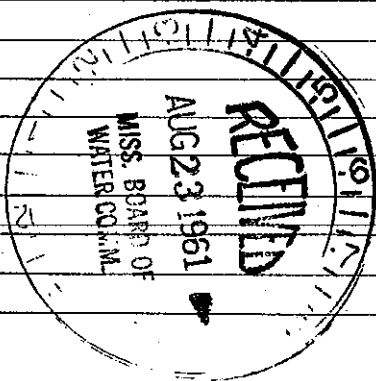

(Use Back Side)

Well No. 23

Mail this copy to Board of Water Commissioners 429 Miss. St. Jackson, Miss