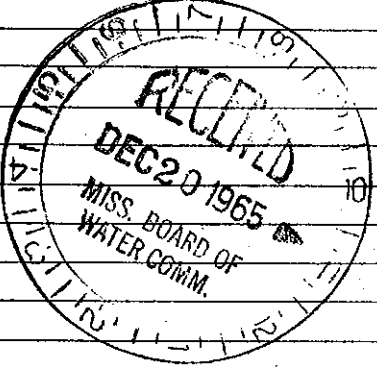


**Forrest MISSISSIPPI BOARD OF WATER COMMISSIONERS**

LK 3 ③

**12-15-65 WATER WELL DRILLERS LOG**

Date: 12-15, 1965, Driller: Jay Gatt County Forrest  
 (Name) Hattiesburg Butane Gas

(1) Owner of Land:	Description & Color of Materials Sand, Clay, Red Clay, Shell, etc.	Thick- ness Feet	Depth Feet
<u>Old Salks Home Forrest</u> (Name) <u>County</u> <u>Rt 3 Purvis</u> (Address) <u>Miss</u>	0-8 <u>yc</u>		
(2) Location: <u>NE 1/4, NW 1/4, Sec. 11 T1N R13W</u>	8-30 <u>WS</u>		
_____ miles _____, of _____ (distance) (direction) (Nearest Town)	30-310 <u>BC</u>		
(3) Topography: <u>flat</u> (Hilly) (Flat) (Level)	310-345 <u>BS</u>		
(4) Purpose of Well: <u>Domestic</u> (Domestic Irrigation Municipal, Industrial, Other)			
Information upon completion of well:			
(1) Diameter <u>2</u> inches.			
(2) Total Depth <u>345</u> feet.			
(3) Water Level <u>55ft.</u> feet below top of ground.			
(4) Cased to _____, Size _____			
(5) Screen: Size <u>2"</u> , Length <u>10ft.</u>			
(6) Were any formations sealed against pollution? _____ yes, _____ no.			
If YES depth of formation _____			
Why _____			
Drillers Remarks: _____			
_____			
_____			
_____			

(Use Back Side)

Well No.