

Forrest
K 2007
7-17-81

MISSISSIPPI DEPARTMENT OF NATURAL RESOURCES
Bureau of Land and Water Resources
Southport Mall
P.O. Box 10631
Jackson, Mississippi 39209
WATER WELL DRILLERS LOG

July 17 1981 *Forrest Anderson Forrest*
date well completed firm name county well located


LANDOWNER *Mrs Mary Eastwing*
Rt 1 Box 178
Lumberton, Ms 39455
(mailing address)

description of formations encountered	from	to
<i>top soil</i>	<i>0</i>	<i>3</i>
<i>clay</i>	<i>3</i>	<i>17</i>
<i>fine sand</i>	<i>17</i>	<i>31</i>
<i>coarse sand</i>	<i>31</i>	<i>53</i>

WELL LOCATION:
sec. *34* T. *1* N. R. *13* E. S. *1*
7 miles *W* of *Brambleton*
(distance) (direction) (nearest town)

WELL PURPOSE: *Home*
(home, irrigation, municipal, industrial)

WELL COMPLETION DATA:
(1) diameter (inches) *2"*
(2) total depth (feet) *53'*
(3) static water level (feet) *30'* below above top of ground.
(4) casing *PVC* *48'*
(material) (depth)
 (size) if telescope see back.
(5) screen *5'* *48'*
(length) (depth to top)
2" *PVC*
(size) (material)
(6) pump *1* *12*
(HP) (yield gpm)
Electric
(type power)
(7) electric log *NO*
(yes or no)
(organization running log)
(8) how well bottom plugged *Capped*

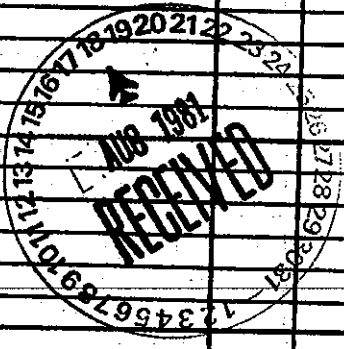

DRILLERS REMARKS: