

FORREST

MISSISSIPPI BOARD OF WATER COMMISSIONERS

L 19 (3)  
3-29-61

WATER WELL DRILLERS LOG

(?)

Date: 3-29, 1961, Driller Trick & Dico County P. R.  
(Name)


(1) Owner of Land: <u>Henry Andrews</u> (Name)	Description & Color of Materials Sand, Clay, Red Clay, Shell, etc.	Thick- ness Feet	Depth Feet
<u>Brocklyn Mass.</u> (Address)	<u>Surface Sand</u>	0	45
(2) Location: <u>NW 1/4, NW 1/4, Sec. 34 T11N R12W</u>	<u>White Clay</u>	45	140
<u>1 1/2 miles South of Brocklyn</u> (distance) (direction) (Nearest Town)	<u>Fine Sand</u>	140	160
(3) Topography: <u>X</u> (Hilly) (Flat) (Level)	<u>Hard Shale</u>	160	440
(4) Purpose of Well: <u>Domestic</u> (Domestic Irrigation Municipal, Industrial, Other)	<u>Good sand</u>	440	487

Henry Andrews

Information upon completion of well:

- (1) Diameter 2 inches.
- (2) Total Depth 487 feet.
- (3) Water Level 100 feet below top of ground.
- (4) Cased to \_\_\_\_\_, Size \_\_\_\_\_.
- (5) Screen: Size 2", Length 5'
- (6) Were any formations sealed against pollution?  
\_\_\_\_\_ yes, X no.

487

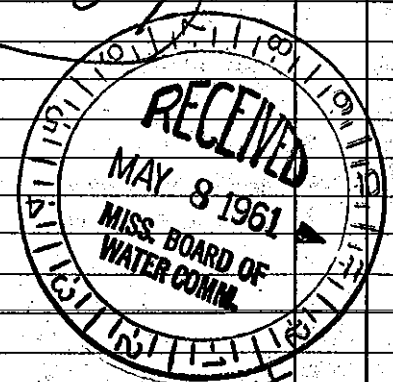

If YES depth of formation \_\_\_\_\_

Why \_\_\_\_\_

Drillers Remarks: Good well.

Cylinder set 12.6'

(Use Back Side)

Mail this copy to Board of Water Commissioners 429 Miss. St. Jackson, N