

BOARD OF WATER COMMISSIONERS

FORREST

L 20

10-11-62

WATER WELL DRILLERS LOG

Date: 10-11, 1962 Driller: Herman Parker County Forrest

(Name)

(1) Owner of Land:	Description & Color of Materials Sand, Clay, Red Clay, Shell, etc.	Thick- ness Feet	Depth Feet
M.O. McCordle (Name) Brooklyn, Miss (Address)	blue clay	65	65
(2) Location: SW 1/4, NW 1/4, Sec. 5 T1N R1W	blue shell	380	445
0 miles in Brooklyn, of (Nearest Town)	sand	62	507
(3) Topography: Flat (Hilly) (Flat) (Level)			
(4) Purpose of Well: domestic (Domestic Irrigation Municipal, Industrial, Other)			


Information upon completion of well:

- (1) Diameter _____ inches.
- (2) Total Depth _____ feet.
- (3) Water Level _____ feet below top of ground.
- (4) Cased to _____, Size _____.
- (5) Screen: Size _____, Length _____.
- (6) Were any formations sealed against pollution?
_____ yes, _____ no.

If YES depth of formation _____

Why _____

Drillers Remarks: _____

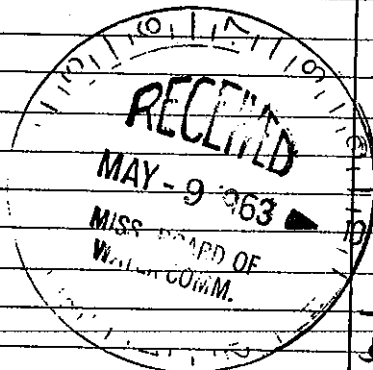

507

Well No.

(Use Back Side)

Mail this copy to Board of Water Commissioners 429 Miss. St. Jackson, Miss