

MISSISSIPPI BOARD OF WATER COMMISSIONERS

FORREST

M 17 D

WATER WELL DRILLERS LOG

Date 6-30-62 1962 Driller: Les Labin County Forrest

(Name)

(1) Owner of Land: J.P. ...
 (Name)
...
 (Address)

Description & Color of Materials Sand, Clay, Red Clay, Shell, etc.	Thick- ness Feet	Depth Feet
<u>Light sand & silt</u>	<u>20</u>	<u>0-20</u>
<u>Sand</u>	<u>11</u>	<u>20-31</u>

(2) Location: 1/4, 1/4, Sec. 12 T. S13
12 miles East, of ...
 (distance) (direction) (Nearest Town)

(3) Topography: Flat
 (Hilly) (Flat) (Level)

(4) Purpose of Well: None
 Domestic Irrigation
 Municipal, Industrial, Other


Information upon completion of well:

- (1) Diameter 2 inches.
- (2) Total Depth 31 feet.
- (3) Water Level 20 feet below top of ground.
- (4) Cased to 26, Size 2
- (5) Screen: Size 9/10, Length 5
- (6) Were any formations sealed against pollution?
no

If YES depth of formation _____

Why _____

Drillers Remarks: _____

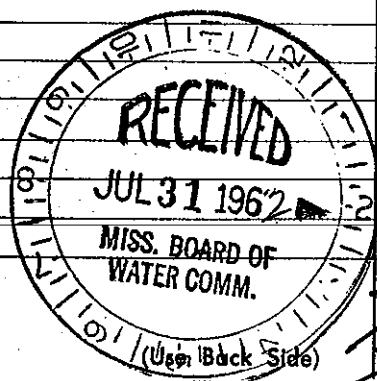

Well No. 2

Retain this copy for your office files.