


FORREST MISSISSIPPI BOARD OF WATER COMMISSIONERS

N7 ③  
11-18-65

WATER WELL DRILLERS LOG

Date: 11-18, 1965, Driller: Antler Well Works County Forrest  
(Name)

	Description & Color of Materials Sand, Clay, Red Clay, Shell, etc.	Thick- ness Feet	Depth Feet
(1) Owner of Land: <u>Hill Scouts of America</u> (Name) <u>M. Wiggins, Miss.</u> (Address)	Red clay	18	18
	sand	91	109
	Clay	43	152
(2) Location: <u>SE 1/4, N E 1/4, Sec. 21 T15 R124</u> <u>2</u> miles <u>S</u> of <u>Maple</u> (distance) (direction) (Nearest Town)	Clay - sand streaks	95	247
	fine sand	24	271
	sand	12	283
(3) Topography: <u>hilly</u> (Hilly) (Flat) (Level)	Clay	34	317
	* sand	27	344
(4) Purpose of Well: <u>Camp</u> (Domestic Irrigation Municipal, Industrial, Other)	Clay	79	423
	Clay - sand streaks	30	453
	** sand	28	481
Information upon completion of well:			
(1) Diameter <u>6</u> inches.			
(2) Total Depth <u>481</u> feet.			
(3) Water Level <u>178</u> feet below top of ground.			
(4) Cased to <u>all</u> , Size <u>6"</u>			
(5) Screen: Size <u>6"</u> , Length <u>* 30'</u>	* 20' strainer set 324' to 344'		
	* 10' strainer set 471' to 481'		
(6) Were any formations sealed against pollution? <input checked="" type="checkbox"/> yes, <input type="checkbox"/> no.			
If YES depth of formation <u>surface</u>			
Why _____			
Drillers Remarks: _____			

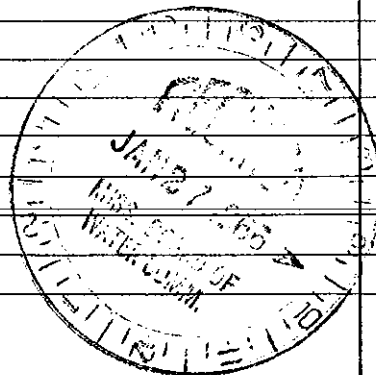

(Use Back Side)

Well No.

Mail this copy to Board of Water Commissioners 429 Miss. St. Jackson, Miss.