

FORREST MISSISSIPPI BOARD OF WATER COMMISSIONERS

NP (6)  
3-30-61

WATER WELL DRILLERS LOG

(?)

Date: 3-30, 1961, Driller: Quirk + Davis County P. R.  
(Name)

(1) Owner of Land	Description & Color of Materials Sand, Clay, Red Clay, Shell, etc.	Thick- ness Feet	Depth Feet
George Moffett (Name)	Surface clay	0	20
Maxie Moss (Address)	Surface sand	20	65
(2) Location: 1/4, 1/4, Sec 17 T15 R12			
1 1/2 miles west of Maxie			
(3) Topography: X (Hilly) (Flat) (Level)			
(4) Purpose of Well: Domestic (Domestic Irrigation, Municipal, Industrial, Other)			

65


Information upon completion of well:

- (1) Diameter 2 inches.
- (2) Total Depth 65 feet.
- (3) Water Level 45 feet below top of ground.
- (4) Cased to \_\_\_\_\_, Size \_\_\_\_\_
- (5) Screen: Size 2", Length 5'
- (6) Were any formations sealed against pollution?  
\_\_\_\_\_ yes, X no.

If YES depth of formation \_\_\_\_\_

Why \_\_\_\_\_

Drillers Remarks: Good well.

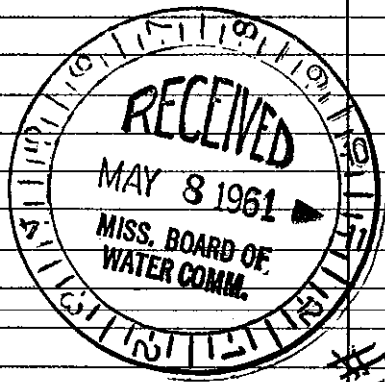

#55

Well No.

(Use Back Side)

Mail this copy to Board of Water Commissioners 429 Miss. St. Jackson, Miss.