

FORREST

MISSISSIPPI BOARD OF WATER COMMISSIONERS

N 7000

WATER WELL DRILLERS LOG

NK  
Forrest  
P.R.

5-7561


Date: 5-7, 1961, Driller: Zuck & Luce County

(Name)


(1) Owner of Land	Description & Color of Materials Sand, Clay, Red Clay, Shell, etc.	Thick- ness Feet	Depth Feet
U.S. Forestry (Name) Midland Park Miss. (Address)	Surface clay	0	30
(2) Location: SW 1/4, SW 1/4, Sec. 35 T <sup>1</sup> R <sup>12</sup>	" " Sand	30	110
At Post Office. (distance) (direction) (Nearest Town)	Red clay	110	120
(3) Topography: <input checked="" type="checkbox"/> (Hilly) <input type="checkbox"/> (Flat) <input type="checkbox"/> (Level)	Good Sand	120	152
(4) Purpose of Well: Industrial (Domestic Irrigation Municipal, Industrial, Other)			

Information upon completion of well:

- (1) Diameter 4 inches.
- (2) Total Depth 152 feet.
- (3) Water Level 35 feet below top of ground.
- (4) Cased to \_\_\_\_\_, Size \_\_\_\_\_.
- (5) Screen: Size 4", Length 20'.
- (6) Were any formations sealed against pollution?  
X yes, \_\_\_\_\_ no.

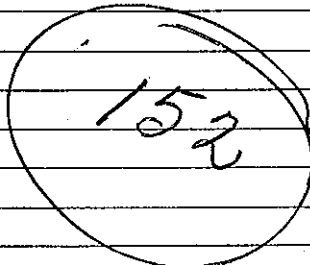

If YES depth of formation 50'  
 Wks: Seal out surface water  
 Drillers Remarks: Good well  
60 gal Per

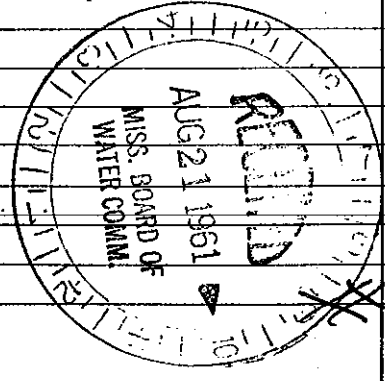

(Use Back Side)

Well No. 61

Mail this copy to Board of Water Commissioners 429 Miss. St. Jackson, Miss.