

FRANKLIN MISSISSIPPI BOARD OF WATER COMMISSIONERS

AI
8-25-60 CODED

WATER WELL DRILLERS LOG

A 300

Date: 8-25, 19___, Driller: Herring Seansett County Franklin
(Name)

(1) Owner of Land: <u>J. J. Dickerson</u> (Name)	Description & Color of Materials Sand, Clay, Red Clay, Shell, etc.	Thick- ness Feet	Depth Feet
<u>Rafai, Miss.</u> (Address)	<u>Red Clay</u>	<u>28'</u>	<u>28'</u>
(2) Location: <u>1/4, 1/4, Sec. 42 T1R1</u>	<u>Sand</u>	<u>7'</u>	<u>35'</u>
<u>3</u> miles <u>N.W.</u> of <u>Rafai</u> (distance) (direction) (Nearest Town)	<u>Clay</u>	<u>51'</u>	<u>92'</u>
(3) Topography: <u>Hilly</u> (Hilly) (Flat) (Level)	<u>Sand & GRAVEL</u>	<u>33'</u>	<u>125'</u>
(4) Purpose of Well: <u>Domestic</u> (Domestic Irrigation Municipal, Industrial, Other)			


Information upon completion of well:

- (1) Diameter 4 3/4 inches.
- (2) Total Depth 125' feet.
- (3) Water Level 40' feet below top of ground.
- (4) Cased to 120', Size 8"
- (5) Screen: Size 2", Length 5'
- (6) Were any formations sealed against pollution?
_____ yes, no.

If YES depth of formation _____

Why _____

Drillers Remarks: _____

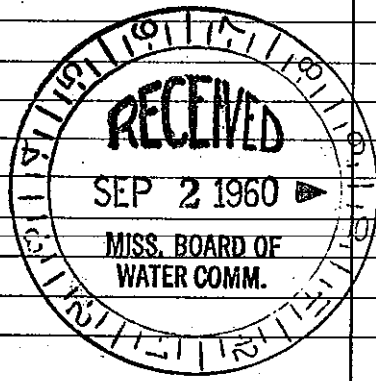

Well No.

(Use Back Side)

Mail this copy to Board of Water Commissioners 429 Miss. St. Jackson, Miss