

MISSISSIPPI DEPARTMENT OF ENVIRONMENTAL QUALITY

Office of Land and Water Resources

P. O. Box 10631
Jackson, MS 39289-0631
WATER WELL DRILLERS LOG

COUNTY WELL LOCATED <u>Franklin</u>	
WELL NUMBER <u>A 2019</u>	CODED
DATE WELL COMPLETED <u>5-28-97</u>	

PERMIT NUMBER Gretn Water Well & Supply
NAME <u>1016 Providence Dr. SE</u> Bogue Chitto, MS 39629

NAME & MAILING ADDRESS OF LANDOWNER <u>Kelvin Doss</u>			
<u>Rt. 2, Box 50</u>			
<u>Rolie MS 39661</u>			
WELL LOCATION	SEC	TOWNSHIP	RANGE
	<u>17</u>	<u>7</u>	<u>N 1 E</u>
DISTANCE	DIRECTION	NEAREST TOWN	
<u>4</u> Miles	<u>NW</u>	of <u>Hamburg</u>	
OTHER LANDMARK			
WELL PURPOSE (Home) <input checked="" type="checkbox"/> Irrigation, Municipal, Industrial, Fish Pond, etc.			

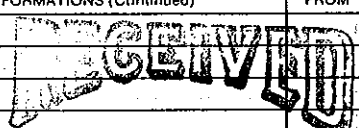
PUMP DATA		
PUMP TYPE (Circle One): <input checked="" type="checkbox"/> Submersible, Turbine, Jet, Flowing Well, Other (Describe) _____		
POWER TYPE (Circle One): <input checked="" type="checkbox"/> Electric, Tractor, Diesel, Gasoline, Butane, Other (Describe) _____ H/P <u>1</u>		
Pump Capacity (GPM)	No. of Stages	Setting Depth
<u>16</u>	<u>10</u>	<u>145</u> FT.
PUMP TEST		
Well yielded <u>16</u> GPM with a drawdown of <u>0</u> ft. after <u>1</u> hours of pumping		

WELL DATA		
Well Depth	Casing Diameter (In.)	Casing Length (Ft.)
<u>230</u>	<u>4</u>	<u>220</u>
Type of Casing	Hole Depth	Depth to Static Water Level
<u>PVC</u>	<u>250</u>	<u>115</u>
TYPE OF COMPLETION: (Circle One or More): <input checked="" type="checkbox"/> Gravel Packed, Underreamed, Telescoped, Natural Development, Open Hole, Other (Describe) _____		
WELL GROUTED TO A DEPTH OF <u>10</u> FEET Type Grout (circle one): Cement, Bentonite, or <input checked="" type="checkbox"/> Mix		

LOG DATA	
TYPE OF LOG RUN (Circle One): Electric, Gamma Ray, Density, Sonic, <input checked="" type="checkbox"/> No Log Run, Neutron, Other (Describe) _____	
Name of Organization Running Log	

SCREEN DATA		
Diameter - Inches	Length - Feet	Slot Size - Inches
<u>4</u>	<u>10</u>	<u>.010</u>
Screen Type	Depth to Bottom - Feet	
<u>PVC</u>	<u>230</u>	

GEOLOGIC DATA (Office Use Only)			
Surface Elev.	Geologic Unit	Unit Thickness	Depth to Top
Subs SWL	Date	Analysis	Aquifer Test
Driller's Remarks			
Top of Lap Pipe or Reduction in Casing			
FEET IF TELESCOPED OR MORE THAN ONE SCREEN: USE BACK PAGE			

DESCRIPTION OF FORMATIONS ENCOUNTERED	FROM	TO	FORMATIONS (Continued)	FROM	TO
Red Clay	0	8	 DEC 19 1997 Dept. of Environmental Quality Office of Land & Water Resources		
White Clay	8	30			
Sand	30	64			
White Clay	64	130			
Blue Clay	130	191			
Sand	191	201			
Blue Clay	201	217			
Sand	217	250			

IF MORE SPACE IS NEEDED, USE BACK