

CODED

Franklin
BI
8-67

MISSISSIPPI
BOARD OF WATER COMMISSIONERS
416 North State Street
Jackson, Mississippi 39201


WATER WELL DRILLERS LOG

Aug 24 1967 Lewis Well Pump Co. Franklin
date well completed firm name county well located

LANDOWNER:	description of formations encountered	from	to
Lee Oliver			
RD. 1	top soil	0	17
Kaplan	white chalk	17	35
(mailing address)	sand & gravel	35	40
WELL LOCATION:	blue shale	40	300
sec 16 T 7 N R 2 E	fine white sand	300	330
2 miles W of Olden	coarse sand	330	350
(distance) (direction) (nearest town)			
WELL PURPOSE: Home			
(home, irrigation, municipal, industrial)			

- WELL COMPLETION DATA:
- (1) diameter (inches) 2"
 - (2) total depth (feet) 350
 - (3) static water level (feet) 255 below top of ground.
 - (4) casing: Steel pipe balton (material) (depth)
 - (5) screen: 6' 344' (length) (depth to top)
2" stainless steel (size) (material)
 - (6) pump: 1 HP (yield gpm)
Rad pump (type power)
 - (7) electric log: no (yes or no)

CODED

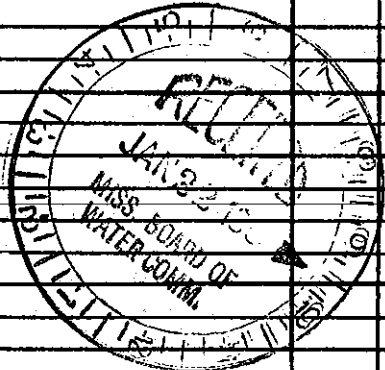

(8) how well bottom plugged: Excess Plug
DRILLERS REMARKS: New location