

Franklin

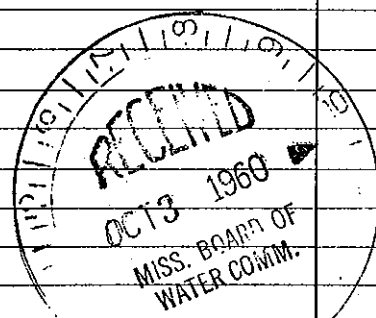
MISSISSIPPI BOARD OF WATER COMMISSIONERS

CJ
9-19-60

WATER WELL DRILLERS LOG

E-300

Date: 9-29, 1960, Driller: Herring Service FT County Franklin
(Name)

	Description & Color of Materials Sand, Clay, Red Clay, Shell, etc.	Thick- ness Feet	Depth Feet
(1) Owner of Land: <u>John Ducker</u> (Name) <u>meville miss</u> (Address)	<u>Red Clay</u>	<u>10'</u>	<u>10'</u>
(2) Location: <u>E 1/2</u> <u>1/4</u> , Sec. <u>8</u> T. <u>7</u> R. <u>3</u> <u>10</u> miles <u>N.W.</u> of <u>Meadville</u> (distance) (direction) (Nearest Town)	<u>Clay</u>	<u>60'</u>	<u>70'</u>
(3) Topography: <input checked="" type="checkbox"/> (Level) (Hilly) (Flat)	<u>Sand</u>	<u>17'</u>	<u>87'</u>
(4) Purpose of Well: <u>Domestic</u> (Domestic Irrigation Municipal, Industrial, Other)			
Information upon completion of well:			
(1) Diameter <u>4 3/4</u> inches.	CODED		
(2) Total Depth <u>87'</u> feet.			
(3) Water Level <u>67'</u> feet below top of ground.			
(4) Cased to <u>82'</u> , Size <u>2"</u>			
(5) Screen: Size <u>2"</u> , Length <u>5'</u>			
(6) Were any formations sealed against pollution? _____ yes, _____ no.			
If YES depth of formation _____			
Why _____			
Drillers Remarks: _____			

(Use Back Side)

Well No.

Mail this copy to Board of Water Commissioners 429 Miss. St. Jackson, Miss.