

MISSISSIPPI DEPARTMENT OF NATURAL RESOURCES
Bureau of Land and Water Resources

P.O. Box 10631
Jackson, Mississippi 39209
WATER WELL DRILLERS LOG

COUNTY WELL LOCATED <u>Franklin</u>	PERMIT NUMBER
WELL NUMBER <u>2006</u>	CODED
DATE WELL COMPLETED <u>7-28-87</u>	NAME OF DRILLING FIRM <u>Gunn Water Well & Sup.</u>

NAME & MAILING ADDRESS OF LANDOWNER <u>Edgar P. Jacks</u> <u>Rt 1 Box 157A</u> <u>Meadville, Inc.</u>			
WELL LOCATION:	SEC	TOWNSHIP	RANGE
	<u>36</u>	<u>7</u>	<u>2</u>
		<u>S</u>	<u>W</u>
DISTANCE <u>4</u> Miles	DIRECTION <u>North</u>	NEAREST TOWN <u>of Meadville</u>	
OTHER LANDMARK			
WELL PURPOSE: Home, Irrigation, Municipal, Industrial, Fish Pond, etc. <u>Home</u>			


PUMP DATA		
PUMP TYPE (Circle One): Submersible, Turbine, Jet, Flowing Well, Other (Describe) <u>did not install</u>		
POWER TYPE (Circle One): Electric, Tractor, Diesel, Gasoline, Butane, Other (Describe)		
Pump Capacity (GPM)	No. of Stages	Setting Depth FT.
PUMP TEST Well yielded <u>57</u> GPM with a drawdown of <u>0</u> ft. after <u>10 min.</u> hours of pumping		

WELL DATA		
Well Depth <u>253</u>	Casing Diameter (In.) <u>4</u>	Casing Length (Ft.) <u>243</u>
Type of Casing <u>PVC</u>	Hole Depth <u>260</u>	Depth to Static Water Level <u>173</u>
TYPE OF COMPLETION: (Circle One or More): <u>Gravel Packed</u> , Underreamed, Telescoped, Natural Development, Open Hole, Other		
Top of Lap Pipe or Reduction in Casing FEET IF TELESCOPED OR MORE THAN ONE SCREEN: USE BACK PAGE		

LOG DATA	
TYPE OF LOG RUN (Circle One): <u>No Log Run</u> Electric, Gamma Ray, Density, Sonic, Neutron, Other (Describe)	
Name of Organization Running Log	

SCREEN DATA		
Diameter - Inches <u>4</u>	Length - Feet <u>10</u>	Slot Size - Inches <u>.010</u>
Screen Type <u>PVC</u>	Depth to Bottom - Feet <u>253</u>	

GEOLOGIC DATA (Office Use Only)			
Surface Elev.	Geologic Unit	Unit Thickness	Depth to Top
Subs. SWL	Date	Analysis	Aquifer Test
Driller's Remarks			

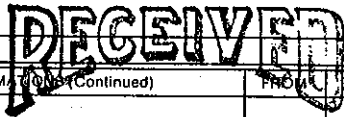

DESCRIPTION OF FORMATIONS ENCOUNTERED	FROM	TO	FORMATIONS (Continued)	FROM	TO
<u>Clay</u>	<u>1</u>	<u>20</u>			
<u>Sand & Gravel</u>	<u>20</u>	<u>145</u>			
<u>white Clay</u>	<u>145</u>	<u>170</u>			
<u>Sand</u>	<u>170</u>	<u>260</u>			

IF MORE SPACE IS NEEDED, USE BACK

AUG 14 1987

Department of Natural Resources
Bureau of Land & Water Resources