

CODED

MISSISSIPPI BOARD OF WATER COMMISSIONERS
416 North State Street
Jackson, Mississippi 39201

WATER WELL DRILLERS LOG

Franklin
D1
12-66

Dec 13 1966 KEEVES WELL & PUMP Franklin
date well completed firm name county well located

LANDOWNER: T. W. Priest
REDL
Meadville, Miss
(mailing address)

description of formations encountered	from	to
chalk clay	0	5
fine white sand	5	50
Coarse white sand	50	73


WELL LOCATION:
sec 22 T 7 N R 4 E
3 1/2 miles NNE of Reddick
(distance) (direction) (nearest town)

WELL PURPOSE: Domestic
(home, irrigation, municipal, industrial)

WELL COMPLETION DATA:
(1) diameter (inches) 4 1/2
(2) total depth (feet) 73
(3) static water level (feet) 30 below top of ground.
(4) casing Plastic Bottom (material) (depth) 67'
(size) if telescope see back.
(5) screen 6' 67" (length) (depth to top)
(size) Plastic (material)
(6) pump 1/2 HP - 12 (HP) (yield gpm)
Electric (type power)
(7) electric log NO (yes or no)
(organization running log)

(8) how well bottom plugged wooden plug

DRILLERS REMARKS:

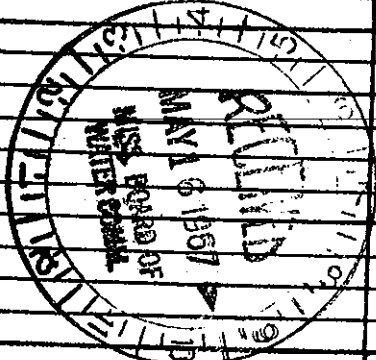

CODED