

CODED

MISSISSIPPI BOARD OF WATER COMMISSIONERS
416 North State Street
Jackson, Mississippi 39201

WATER WELL DRILLERS LOG

Franklin
D2
12-67

12-12 1967 date well completed
Litzner & W Well firm name
Franklin county well located

LANDOWNER: Henry F Zell
Meadville FA MISS
(mailing address)


description of formations encountered	from	to
Top soil & clay	0	20
Sand & gravel	20	50
Chalk	50	104
Sand & gravel	104	126
Chalk	126	

WELL LOCATION:
sec 20 T 4 N R 4 E
7 miles NNE of Meadville
(distance) (direction) (nearest town)

WELL PURPOSE: home
(home, irrigation, municipal, industrial)

- WELL COMPLETION DATA:
- (1) diameter (inches) 4
 - (2) total depth (feet) 126
 - (3) static water level (feet) 95 below top of ground
 - (4) casing plastic (material) 120 (depth)
4" (size) if telescope see back.
 - (5) screen 6' (length) 120 (depth to top)
4" (size) Sch 40 (material)
 - (6) pump _____ (HP) _____ (yield gpm)
Elec (type power)
 - (7) electric log no (yes or no)
(organization running log)
 - (8) how well bottom plugged no

CODED

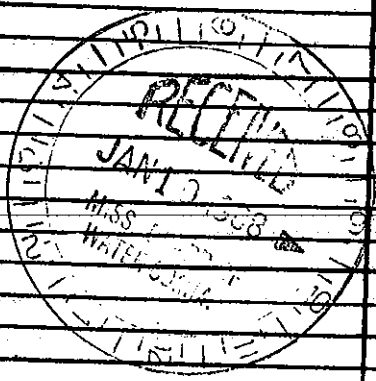

DRILLERS REMARKS: